

NOV 21 1997

LIBER004 PAGE 0082

COMMISSION

LAND CORNER RECORDATION CERTIFICATE
Filing Requirement of Act 74, Mich. P.A. 1970


For corners in

Table with columns: Lake (County), Located In: (20N, 14W), Corner Code # (I-9). Rows include Public Land Survey, Property Controlling in Section, Miscellaneous Property in Sec.

4. Lot No. Recorded Plat
5. Private Claims

REGISTER OF DEEDS
RECORDED
LAKE COUNTY, MI.
Oct 29 3 00 PM '97
Register of Deeds Stamp File Number

Robert L. Wetherell August 29, 97
I, in a field survey on 19 do hereby certify that under requirements of P.A. 74, Michigan P.A. of 1970, the corner points mentioned in lines 1 and 2 above were in conformance with regulations and rules therefore as required in the current manual of survey instructions of the United States Department of the Interior, Bureau of Land Management or by a decree of a Court of Law and/or that the corner points mentioned in lines 3, 4 and 5 above were in conformance with the rules of the Michigan Board of Land Surveyors or by a Decree of a Court of Law, established, re-established, monumented, re-monumented, recovered, found as expressed below:

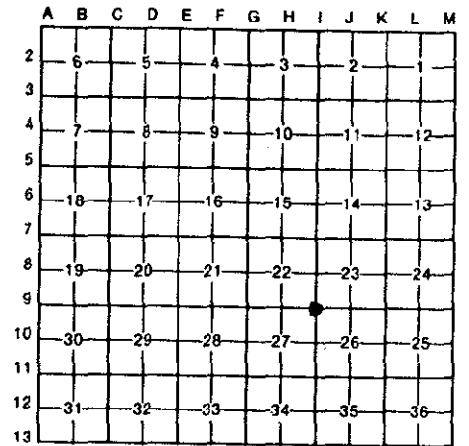

NOTE: Not more than 4 corners, all in the same town and range, may be recorded on this certificate.

A. Description of original monument and accessories and/or subsequent restoration:

I-9 - Section corner common to Sections 22, 23, 26 & 27, T20N, R14W, Lake Co., Mi.

1839 - J. Brink, G.L.O.

#1 - 9" W. Oak S11°W 55 Links

#2 - P. Pine S79°E 10 Links

1907 - J. Millard

"Found 0.71 Links West and 3.81 Links South of Hollister's corner".

#3 - 5" W. Oak S67°E 173'

#4 - 9" B. Oak S7°W 2.23'

1912 - George Johnson, Co. Sur.

#5 - 8" W. Oak N3-1/2°E 116 Links

#6 - 4" W. Oak N50-1/2°E 84 1/2 Links

(SEE OVER FOR CONTINUATION OF "A")

B. Description of corner evidence found and/or method applied in restoring or reestablishing corner:

I-9 - Section corner common to Sections 22, 23, 26 & 27, T20N, R14W, Lake Co., Mi.

I found the 5" Square Concrete Monument by Griffin in intersection of roads East, West, North and South.

Condition of the accessories are as follows: #1 gone, #2 gone, #3 Gone, #4 Gone, #5 gone, #6 Gone, #7 Found in good condition, #8 Found in good condition, #9 Gone, #10 Found in good condition, #11 Gone, #12 Found in good condition.


C. Description of monument for corner and accessories established to perpetuate locating the position of the corner:

I-9 - Section corner common to Sections 22, 23, 26 & 27, T20N, R14W, Lake Co., Mi.

I accepted the 5" Square Concrete Monument as a substantial marker for the corner, and is accepted as a careful and faithful re-establishment of the position of the original corner.

Northeast corner School House Foundation S35°W 112.09'
24" and 18" Tw. W. Oak N24°E 104.36' (60d spike in E. side) #7
11" W. Oak N69°E 133.79' (60d spike in N.W. side)
Power Pole N31°W 51.64' (nail and washer in S.W. side) #10

RATIFIED BY THE LAKE CO. PEER REVIEW GROUP
IN ACCORDANCE WITH P.A. 345
CHAIRMAN RW
DATE 10-23-97

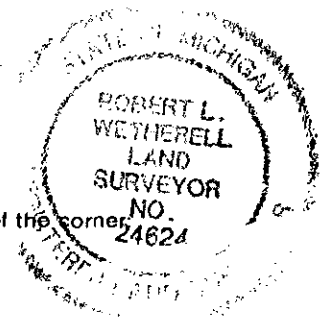

Signed by Robert L. Wetherell 24624

Date 10-28-97

Surveyor's Michigan License No.

CONTINUATION OF "A" - DESCRIPTION OF ORIGINAL MONUMENT AND ACCESSORIES AND/OR SUBSEQUENT RESTORATION:

1918 - George Johnson, Co. Sur.

1-1/4" Pipe

#5 - 10" W. Oak N4°E 77'

#7 - 12" W. Oak N13°E 102'

#8 - School House S32°W 114'

1941- George Blass, LS 5489

Found Iron Rod

#7 - 18" Tw. W. Oak N19°E 104.30'

#9 - 8" W. Oak N21°W 68.50'

#8 - Northeast corner School House S35°W 112.0'

1974 - Clinton E. Cole, LS 17615

7 - 18" Tw. W. Oak N19°E 104.30'

8 - N.E. corner School House S35°W 112.0'

#10 - Power Pole N37°W 52.20'

1976 - Robert Griffin, USFS, LS 13584

L.C.R.C. - Liber 02, Page 282

"Found monument by Blass"

Replaced with 5" Square Concrete Monument

#11 - Post N45°E 46.51'

8 - Northeast corner School House S35°W 112.23'

#12 - Survey Iron S45°W 46.14'

#10 - Power Pole N37°W 51.70'

SURVEY &
REMONUMENTATION

NOV 21 1997

COMMISSION