

SURVEY & REMONUMENTATION

JAN 14 1998

SECTION

LAND CORNER RECORDATION CERTIFICATE
Filing Requirement of Act 74, Mich. P.A. 1970

For corners in Lake

Table with columns: (County), Located In, Corner Code --#

RECORDED LAKE COUNTY, MI. LIBER 004 PAGE 0099

DEC 12 11 38 AM '97

Signature of Registrar

REGISTER OF DEEDS

Register of Deeds Stamp & File Number

4. Lot No. Recorded Plat
5. Private Claims

I, Robert L. Wetherell, in a field survey on August 29, 1997, do hereby certify that under requirements of P.A. 74, Michigan P.A. of 1970, the corner points mentioned in lines 1 and 2 above were in conformance with regulations and rules therefore as required in the current manual of survey instructions of the United States Department of the Interior, Bureau of Land Management or by a decree of a Court of Law and/or that the corner points mentioned in lines 3, 4 and 5 above were in conformance with the rules of the Michigan Board of Land Surveyors or by a Decree of a Court of Law; established, re-established, monumented, re-monumented, recovered, found as expressed below:

Grid table with columns A-M and rows 2-13

NOTE: Not more than 4 corners, all in the same town and range, may be recorded on this certificate.

A. Description of original monument and accessories and/or subsequent restoration:

A-5; M-5; Section corner common to Section 5, T20N, R13W and Section 12, T20N, R14W, Lake Co., Mi.

1837 - John Mullett, G.L.O.
#1 - 10" W. Pine S11°W 27 Links
#2 - 8" W. Pine N32°W 9 Links

1907 - R.H. Hollister
#3 - 5" B. Oak S64°W 87 Links
#4 - 6" W. Oak East 119 Links

Undated - George Johnson, Co. Sur.
16" Stove Grate
#5 - 8" W. Oak S89°E 95'
#6 - 10" B. Oak S16°W 160'

(SEE OVER FOR CONTINUATION OF "A")

B. Description of corner evidence found and/or method applied in restoring or reestablishing corner:

A-5; M-5; Section corner common to Section 5, T20N, R13W and Section 12, T20N, R14W, Lake Co., Mi.

I found the 5" Square Concrete Monument set by Griffin in center of North and South black top road.

Condition of the accessories are as follows: #1 Gone, #2 Gone, #3 Found in good condition, #4 Gone, #5 Found in good condition, #6 gone, #7 Found in good condition, #8 Found in good condition, #9 Found in good condition, #10 Found Capped Iron, #11 Found in good condition, #12 Found in good condition, #13 Found in good condition.

RATIFIED BY THE LAKE CO. PEER REVIEW GROUP IN ACCORDANCE WITH P.A. 345 CHAIRMAN R.K.W. DATE 12-10-97

C. Description of monument for corner and accessories established to perpetuate locating the position of the corner:

A-5; M-5; Section corner common to Section 5, T20N, R13W and Section 12, T20N, R14W, Lake Co., Mi.


I accepted the 5" Square Concrete Monument as a substantial marker for the corner, and is accepted as a careful and faithful re-establishment of the position of the original corner.

- 9" W. Oak S26°E 100.92' (dock spike in S.W. side) #11
9" W. Oak S78°W 130.66' (dock spike in S.E. side) #12
9" W. Oak N59°E 49.05' (found nail in S. side)
11" W. Oak N45°W 95.64' (60d spike in S.W. side)

Signed by Robert L. Wetherell

Date 12-12-97

Surveyor's Michigan License No. 24624

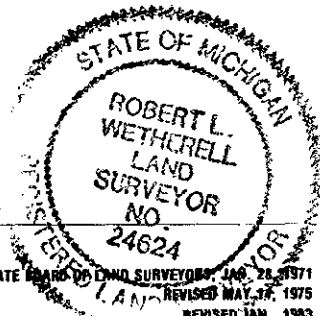

JAN 14 1998

LIBER004 PAGE0100

SECTION
CONTINUATION OF "A" - DESCRIPTION OF ORIGINAL MONUMENT AND ACCESSORIES AND/OR SUBSEQUENT RESTORATION:

1952 - George Blass, LS 5489

Found wood stake - Set 1-1/4" Pipe with stones.

#7 - 8" W. Oak N54°W 95.64'

#8 - 14" Tw. W. Oak N85°E 95.45'

#9 - 18" W. Oak S18°E 79.10'

1967 - Robert Griffin U.S.F.S. - LS 13584

L.C.R.C. - Liber 01, Page 258

Found 1-1/4" Pipe - replaced with 5" Square Concrete Monument

#10 - Iron Rod (set by Blass in 1952) S88°E 33.0'

#11 - 6" W. Oak S30°E 100.90'

#12 - 6" W. Oak S71°W 130.76'

#13 - 4" Pine Post West 33.0'