NOTES 12/18/46

0+0 Starting at corner common to Sections 19, 20, 30 & 29, T6N, R9E going. SOUTH.

13+23 Cross 1/8 line (Fence E&W)

19+86.0 Set property corner between H Tody property on the north and State property on the South. Set temporary marker in fence line to be replaced by anchor post later. (Final posts were set)

0+0 Starting at 1/8 corner, 1/4 mile west of 19/20 30/29 going SOUTH

13+23 Cross 1/8 line, fence E&W.

18+95 ℄ TODY ROAD, WEST, (Gravel) Road goes SOUTH also. (Dirt)

19+0 ℄ House, 80' East, garage in rear

19+86.0 Set property corner in fence line, used temporary marker to be replaced later by post. (Final posts were set)

House and garage is on Tody Land, Chicken Coop is on State Land.

S.J. Higgins

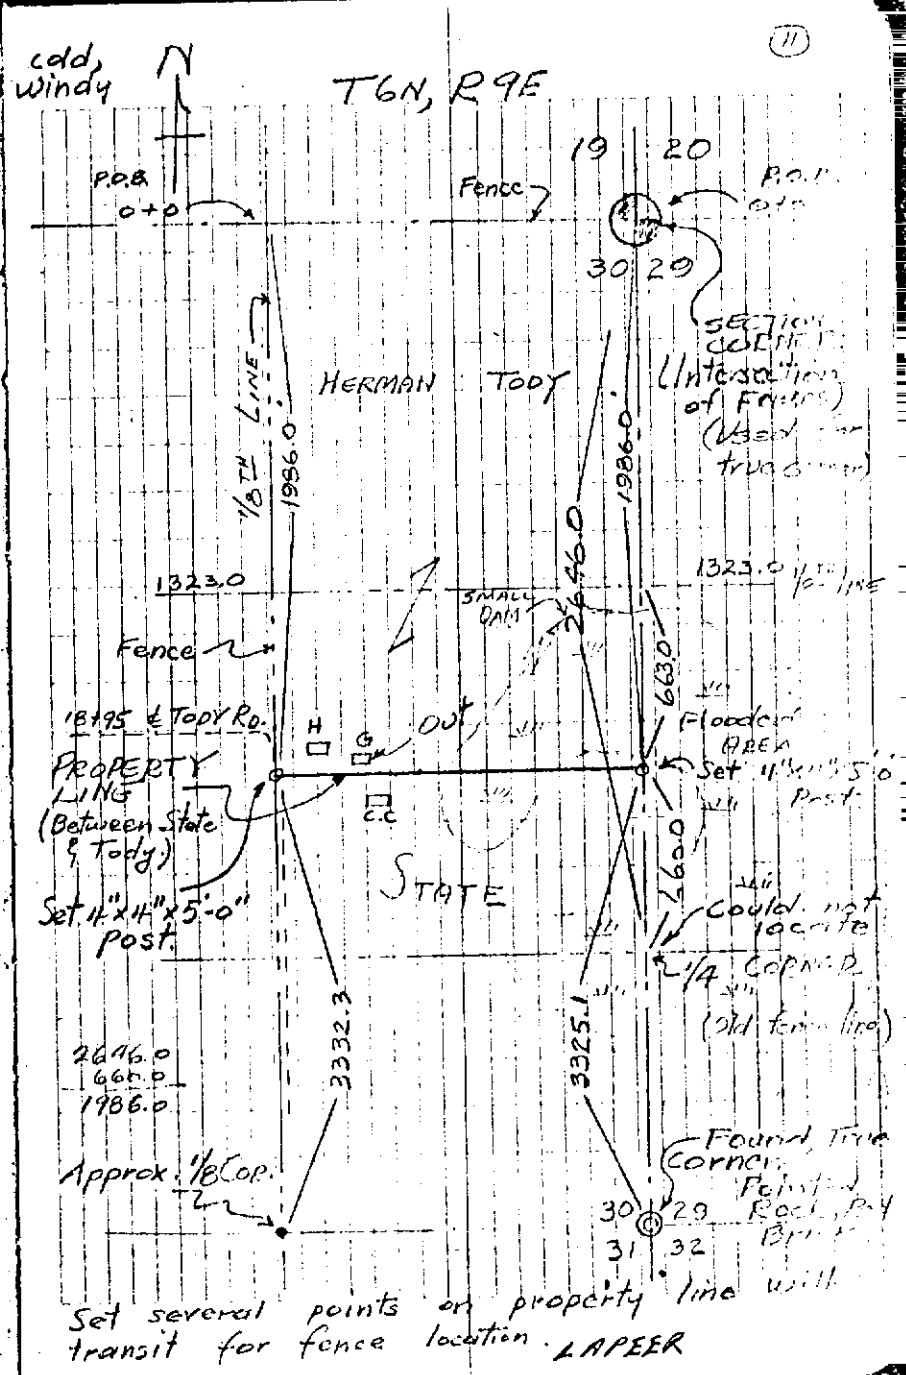

Set several points on property line with transit for fence location. LAPEER