


GLO DESCRIPTION
T6N, R9E


28 27
33 34

80.40

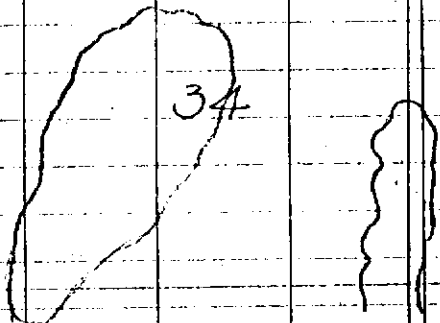

T6N, 9E

(7)

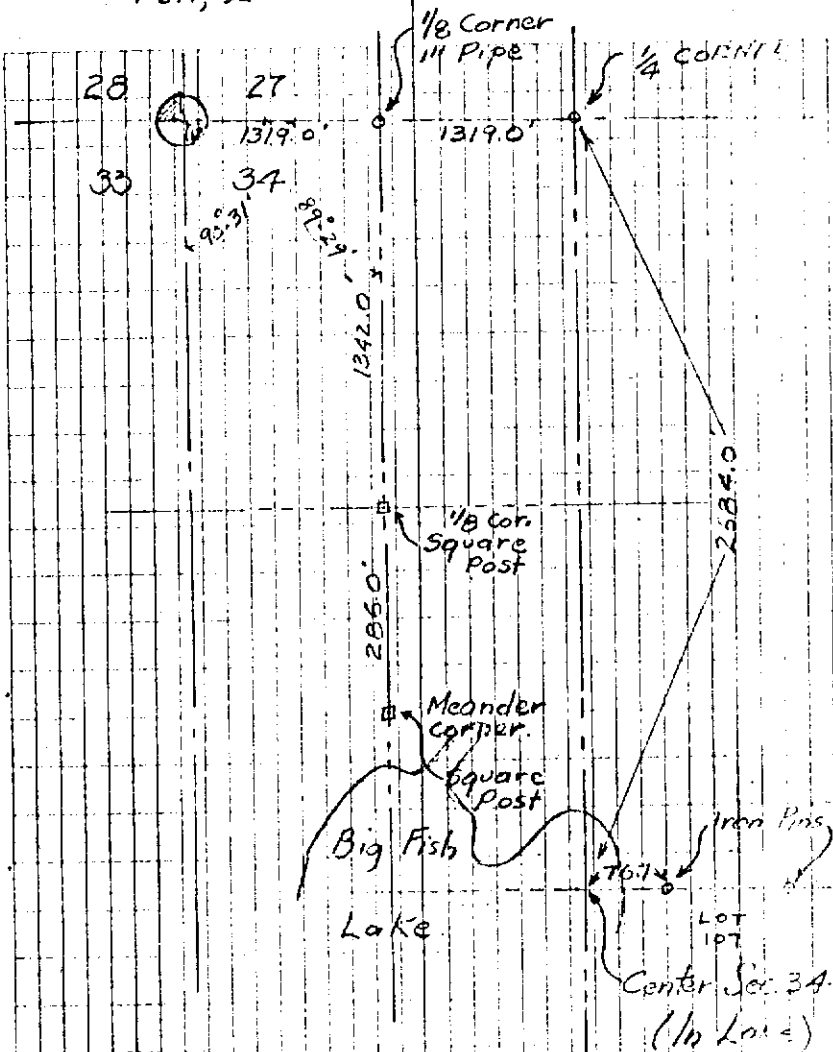

LAPPEER