

**SURVEY &
REMONUMENTATION**

MAR 23 2000

**LAND CORNER RECORDATION CERTIFICATE
Filing Requirement of Act 74, Mich. P.A. 1970**

SECTION

For corners in

<u>Lapeer</u> (county)	Located In:	Corner Code #
	Hadley Twp	
1. Public Land Survey	T <u>6N</u> R <u>9E</u>	<u>C-13</u>
	T ___ R ___	_____
	T ___ R ___	_____
	T ___ R ___	_____
2. Property Controlling in Section	S ___ T ___ R ___	_____
	S ___ T ___ R ___	_____
3. Miscellaneous Property in Sec.	S ___ T ___ R ___	_____
	S ___ T ___ R ___	_____

RECEIVED FOR RECORD

00 FEB 10 PM 2:41

Melissa DeVaugh
REGISTER OF DEEDS
LAPEER COUNTY MICHIGAN

499

Register of Deeds Stamp & File Number

4. Lot No. _____, Recorded Plat _____

5. Private Claims _____

I, James E. Kovas, in a field survey on January 17, 2000, do hereby certify that under requirements of P.A. 74, Michigan P.A. of 1970, the corner points mentioned in lines 1 and 2 above were in conformance with regulations and rules therefore as required in the current manual of survey instructions of the United States Department of the Interior, Bureau of Land Management or by a decree of a Court of Law and/or that the corner points mentioned in lines 3, 4 and 5 above were in conformance with the rules of the Michigan Board of Land Surveyors or by a Decree of a Court of Law; established, re-established, monumented, re-monumented, recovered, found as expressed below:

	A	B	C	D	E	F	G	H	I	J	K	L	M
2		6		5		4		3		2		1	
3													
4		7		8		9		10		11		12	
5													
6		18		17		16		15		14		13	
7													
8		19		20		21		22		23		24	
9													
10		30		29		28		27		26		25	
11													
12		31		32		33		34		35		36	
13													

NOTE: Not more than 4 corners, all in the same town and range, may be recorded on this certificate.

A. Description of original monument and accessories and/or subsequent restoration:

C-13
1816 - G.L.O., South Carpenter, D.S., Post set

Distances: C-13 to C-1 = (Brandon) 60.72' east (Wade-Trim, 1999)
C-13 to C-1 = (Brandon) 60.72' east (92 links GLO, 1816)
C-13 to B-13 = 2654.11' (Wade-Trim, 1998)
C-13 to D-13 = 2654.11' (Wade-Trim, 1998)

B. Description of corner evidence found and/or method applied in restoring or reestablishing corner:

C-13 No monument found.

This corner falls in the State Park land. A search was made, but no evidence of the corner or any possession evidence was found. The Lapeer County Committee instructed Wade-Trim to set C-13 on line between B-13 and D-13 at the split distance between B-13 to D-13. C-1 (Brandon) was set at the GLO record 92 links east of this computed position for C-13 (Hadley).

ACCEPTED 11/10/99 by Lapeer County Peer Review.


C. Description of monument for corner and accessories established to perpetuate locating the position of the corner:

C-13 Found 5/8" iron. Removed and replaced with 1/2" iron with Lapeer County Remon cap in center line of County Line Road.

WIT: N 75 W 52.95' Set P.K. nail w/Lapeer County Remon tag 8" Hickory
N 15 W 26.78' Set P.K. nail w/Lapeer County Remon tag 8" Oak
S 05 W 20.32' Set P.K. nail w/Lapeer County Remon tag 8" Oak
S 46 W 34.69' Set P.K. nail w/Lapeer County Remon tag 14" Oak
East 60.72' Found concrete monument Oakland Remon cap for C-1

PEER GROUP
APPROVED LAND CORNER
PA 043 OF 1990
LAPEER COUNTY

RAY DAVIS P.S. CO. SURVEYOR
DATE 11-10-1999

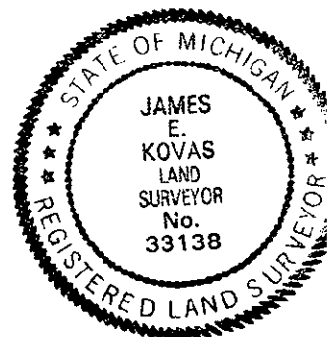

Signed by James E. Kovas Date 2/7/00

Surveyor's Michigan License No. 33138