SURVEY &
REMONUMENTATION

APR 2 9 1996

COMMISSION

LAND CORNER RECORDATION CERTIFICATE

Filing Requirement of Act 74, Mich. P.A. 1970

For corners in Lapeer (County) Located In: Hadley Twp. Corner Code #

RECEIVED FOR RECORD

95 AUG -4 AM 11: 12

LIBER NO. 005 PAGE NO. 235

Melissa DeVaugh

REGISTER OF DEEDS
LAPEER COUNTY, MICHIGAN

Register of Deeds Stamp & File Number

1. Public Land Survey T 6N R 9E J-13
   T ___ R ___
   T ___ R ___
   T ___ R ___
2. Property Controlling S ___ T ___ R ___
   in Section S ___ T ___ R ___
3. Miscellaneous S ___ T ___ R ___
   Property in Section S ___ T ___ R ___

4. Lot No. _____, Recorded Plat _____
5. Private Claims _____

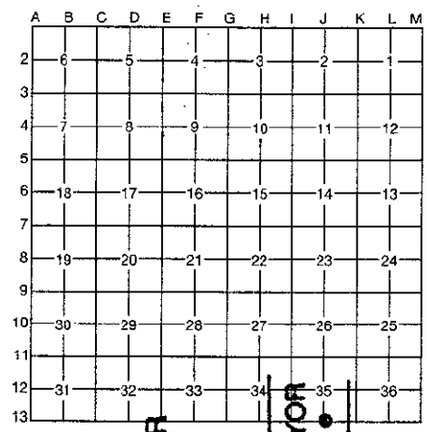

I, Huston K. Kennedy, in a field survey on March 28, 19 95, do hereby certify that under requirements of P.A. 74, Michigan P.A. of 1970, the corner points mentioned in lines 1 and 2 above were in conformance with regulations and rules therefore as required in the current manual of survey instructions of the United States Department of the Interior, Bureau of Land Management or by a decree of a Court of Law and/or that the corner points mentioned in lines 3, 4 and 5 above were in conformance with the rules of the Michigan Board of Professional Surveyors or by a Decree of a Court of Law; established, re-established, monumented, re-monumented, recovered, found as expressed below:

NOTE: Not more than 4 corners, all in the same town and range, may be recorded on this certificate.

PEER GROUP
APPROVED LAND CORNER
PA 345 OF 1990
LAPEER COUNTY
RAY DAVIS P.S. CO. SURVEYOR
DATE APPROVED 7-13-95

A. Description of original monument and accessories and/or subsequent restoration:

1817-GLO Carpenter, D.S.; Set Post; 10" Elm N36°W 16 Links; 11" Maple S07°E 23 Links
1.) 1977-Bates, PS #16699; LCRC L.003, Pg.35 - Fnd 3/8" Iron Rod
2.) 1977-Bates, PS #16699; Survey L.004, Pg.399 - Fnd 3/8" Iron Rod, used same wit as 1977 LCRC
3.) 1979-Elrich, PS #18986; Survey L.005, Pg.311 - Fnd 3/8" Iron Rod, used same wit as 1977 LCRC
4.) 1987-Flint Surveying & Engineering; Unrecorded Survey - Fnd 1" Gas Pipe
5.) 1990-Gravlin, PS #23510; Unrecorded Survey - Fnd Pipe

B. Description of corner evidence found and/or method applied in restoring or reestablishing corner:

1995-Kennedy Survey, Inc. - Kennedy, P.S. #17623 - Fnd 5/8" Iron Pipe in the centerline of Davison Lake Road, which has a gravel surface with a tree row extending to the North. The North 1/4 corner of Section 2, T5N, R9E, Brandon Twp, (J-1) is located 21.62 feet to the East.

Witnesses from LCRC #1 were used to recover and verify the location of the found 5/8" Iron Pipe.

I accepted the found 5/8" Iron Pipe as the best evidence of the original corner position.

FIELD MEASUREMENTS BETWEEN

J-13 to K-13 2661.29 Ft., GLO = 40 chains or 2640.00 Ft.
J-13 to J-1 (Brandon Twp.) 21.62 Ft.

C. Description of monument for corner and accessories established to perpetuate locating the position of the corner:

J-13 I replaced the found 5/8" Iron Pipe with a 1/2" x 24" Iron Rod w/2" diameter brass cap stamped Lapeer County Remonumentation #17623 J-13
N24°W 37.22' Set Nail & Remon. Washer SW face 31" Oak
N46°W 29.45' Set Nail & Remon. Washer SW face 6" Elm
S09°W 18.93' Set Nail & Remon. Washer West face 13" Elm
S50°W 29.03' Set Nail & Remon. Washer SE face 14" Elm
East 21.62 feet North 1/4 corner Section 2, T5N, R9E, Brandon Twp. (J-1)

The selected location is accepted by me and is generally accepted by Professional Surveyors as the best available evidence of the position of the original corner.

Signed by _____ Date July 17, 1995

Surveyor's Michigan License No. 17623

STATE OF MICHIGAN
HUGTON KENNEDY
PROFESSIONAL SURVEYOR
17623
APPROVED PROFESSIONAL SURVEYOR

FORM APPROVED BY MICHIGAN STATE BOARD OF PROFESSIONAL SURVEYORS, JAN. 28, 1971
REVISED MAY 14, 1975
REVISED JAN. 1987

LIBER 0005 PAGE 0235