

**SURVEY &
REMONUMENTATION**

MAR 23 2000

REMONUMENTATION

RECEIVED FOR RECORD

99 DEC 23 AM 9:14

SECTION

LAND CORNER RECORDATION CERTIFICATE
Filing Requirement of Act 74, Mich. P.A. 1970

For corners in


Lapeer
(County)

Located In:
Hadley Township

Corner Code #

Melissa De Vaughn
REGISTER OF DEEDS
LAPEER COUNTY, MICHIGAN

1. Public Land Survey		<u>T6N</u>	<u>R9E</u>	<u>K-1</u>
		T	R	
		T	R	
		T	R	
2. Property Controlling in Section	<u>S</u>	T	R	
	S	T	R	
3. Miscellaneous Property in Sec.	<u>S</u>	T	R	
	S	T	R	

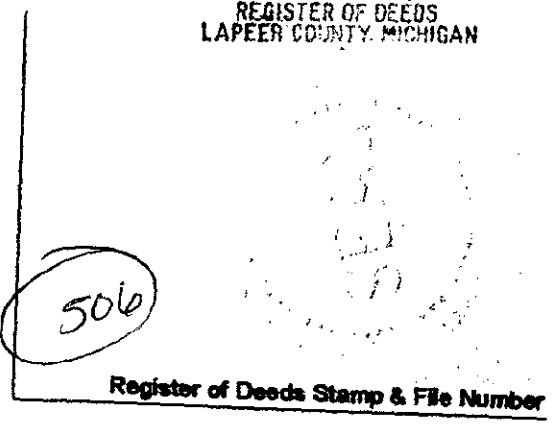

4. Lot No. _____ Recorded Plat _____
5. Private Claims _____

	A	B	C	D	E	F	G	H	I	J	K	L	M
1													
2	6		5		4		3		2		1		
3													
4	7		8		9		10		11		12		
5													
6	18		17		16		15		14		13		
7													
8	19		20		21		22		23		24		
9													
10	30		29		28		27		26		25		
11													
12	31		32		33		34		35		36		
13													

I, Huston K. Kennedy, in a field survey on August 11, 1999 do hereby state that under requirements of P.A. 74, Michigan P.A. of 1970, the corner points mentioned in lines 1 and 2 above were in conformance with regulations and rules therefore as required in the current manual of survey instructions of the United States Department of the Interior, Bureau of Land Management or by a decree of a Court of Law and/or that the corner points mentioned in lines 3, 4 and 5 above were in conformance with the rules of the Michigan Board of Land Surveyors or by a Decree of a Court of Law, established, re-established, monumented, recovered, found as expressed below.

NOTE: Not more than 2 corners, all in the same town and range, may be recorded on this certificate.

- A. Description of original monument and accessories and/or subsequent restoration:
1817-GLO Wampler, D.S.; Set Post 14" White Oak S20 1/2°E 67 Links; 21" White Oak S72°W 19 Links
1.) 1995-Kennedy, PS #17623; LCRC for (K-13 Elba Twp.) L.0005, Pg.0233 - Fnd a 1/2" Iron Rod
2.) 1995-Flint Surveying, Inc.; Unrecorded Survey - Fnd a 1/2" Re-rod
3.) 1997-Flint Surveying, Inc.; Unrecorded Survey - Fnd a 1/2" Re-rod
- B. Description of corner evidence found and/or method applied in restoring or reestablishing corner:
1999-Kennedy Surveying, Inc. - Kennedy, PS #17623 - Fnd a 1/2" Iron Rod located in the intersection of the existing centerline of Stewart Road projected to the West, which has a gravel surface, also in the existing centerline of Herd Road projected to the North, which has a gravel surface, also found a second 1/2" Iron Rod w/cap (#9189 CHC) 2.80 feet to the East. Corner common to Sections 35 & 36, T7N, R9E, Elba Township (K-13) is located 216.87 feet to the East. K-1 as found is 0.24 feet North of the town line.

Witnesses from Unrecorded Witnesses #2 & 3 were used to recover and verify the location of the found 1/2" Iron Rod without a cap.

I accepted the found 1/2" Iron Rod without a cap as the best evidence of the original corner position.

FIELD MEASUREMENTS BETWEEN

K-1 to J-1
No GLO, corner falls in a lake
No recorded distances
2618.98 Ft. (CAL)

K-1 to L-1
No GLO
Unrecorded Survey by Flint Surveying dated 4/26/95 = 2639.07 Ft.
2639.49 Ft. (MEA 1998)



- C. Description of monument for corner and accessories established to perpetuate locating the position of the corner:
K-1 I replaced the found 1/2" Iron Rod with a 1/2" x 24" Iron Rod w/2" diameter brass cap stamped Lapeer County Remonumentation, #17623
N87°E 17.05' Set Mag Nail & Remon Washer North face 28" Basswood East 2.80' found 1/2" Iron Rod w/cap (#9189 CHC)
Due West 1.75' Set Mag Nail & Remon Washer South face 26" Basswood
N05°E 30.74' Set Mag Nail & Remon Washer East face 14" Walnut
S12°W 28.02' Set Mag Nail & Remon Washer East face 13" Cherry
East 216.87 feet corner common to Sections 35 & 36, T7N, R9E, Elba Township (K-13)

The selected location is accepted by me and is generally accepted by Professional Surveyors as the best available evidence of the position of the original corner.

Signed by: [Signature] Date 11-19-99
Surveyor's Michigan License No. 17623

SURVEY &
REMONUMENTATION

MAR 23 2000

SECTION

K-1 to K-13

GLO = 20 links or 13.20 Ft.

Unrecorded Survey by Flint Surveying, Inc. dated 4/26/95 = 217.20 Ft.
216.87 Ft. (MEA 1995)

MISS D	7.00
TEMP C	10075
REMOVT	2.00

FIELD GROUP
APPROVED FIELD CORNER
PAGE 06 OF 1890

RAY DAVIS P.S. CO. SURVEYOR
DATE 10-21-99