

SURVEY & REMONUMENTATION

OCT 29 1996

COMMISSION

REMONUMENTATION
LAND CORNER RECORDATION CERTIFICATE
 Filing Requirement of Act 74, Mich. P.A. 1970


RECEIVED FOR RECORD

96 SEP 30 PM 3:20

For corners in Lapeer
 (County)

Located in: Hadley Twp. Corner Code #

| | | | | | |
|--------------------------------------|---|-----------|---|-----------|------------|
| 1. Public Land Survey | T | <u>6N</u> | R | <u>9E</u> | <u>M-5</u> |
| | T | | R | | |
| | T | | R | | |
| | T | | R | | |
| 2. Property Controlling in Section | S | | T | | R |
| | S | | T | | R |
| 3. Miscellaneous Property in Section | S | | T | | R |
| | S | | T | | R |

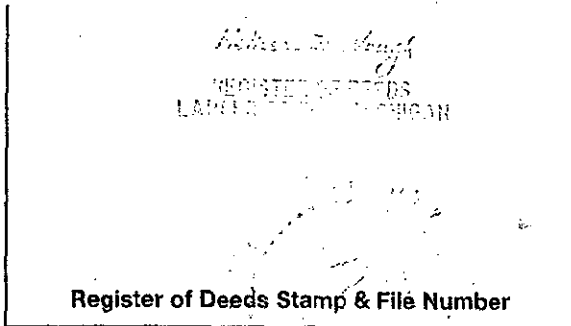

4. Lot No. _____, Recorded Plat _____
 5. Private Claims _____

| A | B | C | D | E | F | G | H | J | K | L | M |
|----|----|----|----|----|----|----|---|---|---|---|---|
| 2 | 6 | 5 | 4 | 3 | 2 | 1 | | | | | |
| 3 | | | | | | | | | | | |
| 4 | 7 | 8 | 9 | 10 | 11 | 12 | | | | | |
| 5 | | | | | | | | | | | |
| 6 | 18 | 17 | 16 | 15 | 14 | 13 | | | | | |
| 7 | | | | | | | | | | | |
| 8 | 19 | 20 | 21 | 22 | 23 | 24 | | | | | |
| 9 | | | | | | | | | | | |
| 10 | 30 | 29 | 28 | 27 | 26 | 25 | | | | | |
| 11 | | | | | | | | | | | |
| 12 | 31 | 32 | 33 | 34 | 35 | 36 | | | | | |
| 13 | | | | | | | | | | | |

I, Huston K. Kennedy, in a field survey on JUNE 3, 19 96, do hereby certify that under requirements of P.A. 74, Michigan P.A. of 1970, the corner points mentioned in lines 1 and 2 above were in conformance with regulations and rules therefore as required in the current manual of survey instructions of the United States Department of the Interior, Bureau of Land Management or by a decree of a Court of Law and/or that the corner points mentioned in lines 3, 4 and 5 above were in conformance with the rules of the Michigan Board of Professional Surveyors or by a Decree of a Court of Law; established, re-established, monumented, re-monumented, recovered, found as expressed below:

NOTE: Not more than 4 corners, all in the same town and range, may be recorded on this certificate.

A. Description of original monument and accessories and/or subsequent restoration:

1817-GLO Samuel Carpenter, D.S.; Set Post; 14" White Oak S40.5°W 114 Links; 20" White Pine N51.5°W 2.39 Chains
 I was unable to recover any recorded or unrecorded Land Corner Recordation Certificates or Certificates of Survey for this corner.

PEER GROUP
 APPROVED LAND CORNER
 PA 345 OF 1990
 LAPEER COUNTY

RAY DAVIS P.S. CO. SURVEYOR

B. Description of corner evidence found and/or method applied in restoring or reestablishing corner:

1996-Kennedy Survey, Inc. - Kennedy, P.S. #17623 - Fnd 5/8" Square Iron Rod 4" below the surface, 2 feet West of the centerline of Baldwin Road extending to the North & South, which has a gravel surface. Corner common to Sections 7 & 18, T6N, R10E, Metamora Twp., (A-5) is location 80.31 feet to the South with the existing centerline of Caley Road extending to the East, which has a gravel surface. The only way I could verify the location of the found 5/8" Square Iron Rod was the relationship between the GLO & measured distances between M-5 & A-5

DATE 7-16-96

I accepted the found 5/8" Square Iron Rod as the best evidence of the original corner position.


FIELD MEASUREMENTS BETWEEN

M-5 to M-4 GLO = 40 chains or 2640.00 Ft. M-5 to A-5 80.31 Ft. (N)
 M-5 to M-6 GLO = 40 chains or 2640.00 Ft. M-5 to M-6 2650.21 Ft. (N)
 M-5 to A-5 GLO = 1.20 chains = 79.20 Ft. (South) M-5 to M-4 2643.18 Ft. (N)

C. Description of monument for corner and accessories established to perpetuate locating the position of the corner:

M-5 I replaced the found 5/8" Square Iron Rod with a 1/2" x 24" Iron Rod w/2" diameter brass cap stamped Lapeer County Remonumentation M-5
 N81°E 43.25' Set PK & Remon. Washer NW face Power Pole
 N30°W 115.20' Set PK & Remon. Washer NE face 12" Elm
 S44°W 99.60' Set PK & Remon. Washer SE face 13" Oak
 South 80.31 feet corner common to Sections 7 & 18, T6N, R10E, Metamora Twp., (A-5)

The selected location is accepted by me and is generally accepted by Professional Surveyors as the best available evidence of the position of the original corner.

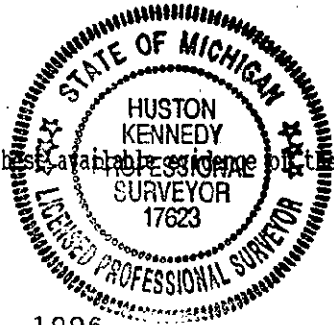

Signed by [Signature]
 Surveyor's Michigan License No. 17623

Date July 17, 1996