

SURVEY &  
REMONUMENTATION

1993

COMMISSION

REMONUMENTATION  
LAND CORNER RECORDATION CERTIFICATE  
Filing Requirement of Act 74, Mich. P.A. 1970

For corners in

<u>LAPEER</u> (County)	Located In:	Corner Code #
1. Public Land Survey	T <u>6</u> N R <u>9</u> E	<u>M-12</u>
	T _____ R _____	_____
	T _____ R _____	_____
	T _____ R _____	_____
2. Property Controlling in Section	S _____ T _____ R _____	_____
	S _____ T _____ R _____	_____
3. Miscellaneous Property in Sec.	S _____ T _____ R _____	_____
	S _____ T _____ R _____	_____
4. Lot No. _____, Recorded Plat _____		
5. Private Claims _____		

RECEIVED FOR RECORD

93 DEC 30 AM 10:23

LIBER NO. 5 FILE NO. 55  
*Melissa Miles*  
REGISTER OF DEEDS  
LAPEER COUNTY, MICHIGAN

Register of Deeds Stamp & File Number

I, Huston K. Kennedy, in a field survey on November, 19 93, do hereby certify that under requirements of P.A. 74, Michigan P.A. of 1970, the corner points mentioned in lines 1 and 2 above were in conformance with regulations and rules therefore as required in the current manual of survey instructions of the United States Department of the Interior, Bureau of Land Management or by a decree of a Court of Law and/or that the corner points mentioned in lines 3, 4 and 5 above were in conformance with the rules of the Michigan Board of Land Surveyors or by a Decree of a Court of Law; established, re-established, monumented, re-monumented, recovered, found as expressed below:

**NOTE: Not more than 4 corners, all in the same town and range, may be recorded on this certificate.**

	A	B	C	D	E	F	G	H	I	J	K	L	M
2	6	5	4	3	2								
3													
4	7	8	9	10	11	12							
5													
6	18	17	16	15	14	13							
7													
8	19	20	21	22	23	24							
9													
10	30	29	28	27	26	25							
11													
12	31	32	33	34	35	36							
13													

A. Description of original monument and accessories and/or subsequent restoration:

- 1817 GLO - Wampler, D.S.; Set 1/2 mile post; 9" White Oak S13°E 29 lks.; 10" White Oak N13°E 50 lks.
- 1972 Henderson, P.S. #16043; LCRC L.1, Pg.581 - Fnd 1/2" iron rod
- 1972 Henderson, P.S. #16043; Survey L.1, Pg.752; Same wits as 1972 LCRC
- 1974 Pawlaczyk, P.S. #17632; Survey L.2, Pg.886 - Fnd 1/2" iron rod
- 1974 Pawlaczyk, P.S. #17632; LCRC L.2, Pg.663-664 - Fnd iron; Same wits as 1974 survey


B. Description of corner evidence found and/or method applied in restoring or reestablishing corner:

1993 Kennedy Surveying, Inc. - Kennedy, P.S. #17623; Fnd 1/2" iron rod center of Baldwin Road, which is gravel, with a fence/tree line to the West.  
The witness trees were still existing, but the witnesses were grown over. The witness trees were used to recover the found 1/2" iron rod.

I accepted the found 1/2" iron rod as best evidence of original corner position.

C. Description of monument for corner and accessories established to perpetuate locating the position of the corner:

- M-12 - 1/2" x 24" iron rod with 3" diameter brass cap.
- S84°W - 27.05' Set nail w/remon. tag below existing witness in S. face 43" Oak
- S31°W - 51.65' Set nail w/remon. tag in SE face 17" Ash
- S21°E - 78.38' Set nail w/remon. tag in E face 24" Elm
- S57°E - 32.22' Set nail w/remon. tag in N face 12" Cherry
- N41°E - 47.67' Set nail w/remon. tag in NW face 16" Cherry

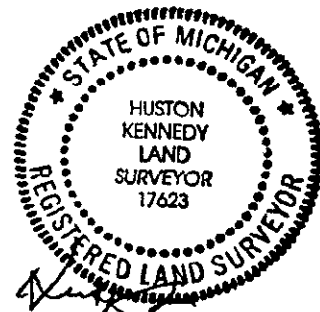

Signed by *Huston K. Kennedy*  
Surveyor's Michigan License No. 17623

Date 11/20/93