

1993

COMMISSION

REMONUMENTATION  
LAND CORNER RECORDATION CERTIFICATE  
Filing Requirement of Act 74, Mich. P.A. 1970

RECEIVED FOR RECORD

For corners in

LAPEER  
(County)

Located In:

Corner Code #

- |                                    |                           |       |
|------------------------------------|---------------------------|-------|
| 1. Public Land Survey              | T <u>6</u> N R <u>9</u> E | M-13  |
|                                    | T _____ R _____           | _____ |
|                                    | T _____ R _____           | _____ |
|                                    | T _____ R _____           | _____ |
| 2. Property Controlling in Section | S _____ T _____ R _____   | _____ |
|                                    | S _____ T _____ R _____   | _____ |
| 3. Miscellaneous Property in Sec.  | S _____ T _____ R _____   | _____ |
|                                    | S _____ T _____ R _____   | _____ |
4. Lot No. \_\_\_\_\_, Recorded Plat \_\_\_\_\_
5. Private Claims \_\_\_\_\_


93 DEC 30 AM 10:24

LIBER # 5 FILE NO. 56  
*Melissa Miles*  
REGISTERED LAND SURVEYOR  
LAPEER COUNTY MICHIGAN

Register of Deeds Stamp & File Number

I, Huston K. Kennedy, in a field survey on November, 19 93, do hereby certify that under requirements of P.A. 74, Michigan P.A. of 1970, the corner points mentioned in lines 1 and 2 above were in conformance with regulations and rules therefore as required in the current manual of survey instructions of the United States Department of the Interior, Bureau of Land Management or by a decree of a Court of Law and/or that the corner points mentioned in lines 3, 4 and 5 above were in conformance with the rules of the Michigan Board of Land Surveyors or by a Decree of a Court of Law; established, re-established, monumented, re-monumented, recovered, found as expressed below:

**NOTE: Not more than 4 corners, all in the same town and range, may be recorded on this certificate.**

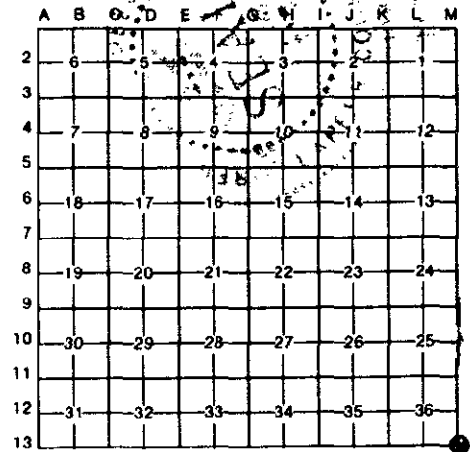

A. Description of original monument and accessories and/or subsequent restoration:


- 1817 GLO- Wampler, D.S.; Set post; 15" Black Oak S74°E 37 lks., 15" White Oak N52°E 77lks.
- 1974 Pawlaczyk, P.S. #17632; Survey L.2, Pg.886 - Fnd iron
- 1974 Pawlaczyk, P.S. #17632; LCRC L.2, Pg663-664 - Fnd iron; Same wits as 1974 survey
- 1978 Kennedy, P.S. #17623; LCRC L.3, Pg.386 - Fnd iron rod

B. Description of corner evidence found and/or method applied in restoring or reestablishing corner:

- 1993 Kennedy Surveying, Inc. - Kennedy, P.S. #17623 - Fnd 1/2" iron rod at the intersection of Baldwin Road and Davison Lake Road. Both are gravel roads. The witness trees were still existing, but the witnesses were grown over. The witness trees were used to recover the found 1/2" iron rod. Accepted found 1/2" iron rod as best evidence of original corner position.

C. Description of monument for corner and accessories established to perpetuate locating the position of the corner:

- M-13 - 1/2" x 24" iron rod with 3" diameter brass cap.
- N70°E - 80.78' Set nail w/remon. tag above existing witness in S. face 34" Oak
- N35°W - 50.90' Set nail w/remon. tag in E. face 24" Oak
- N69°W - 71.84' Set nail w/remon. tag above existing witness in S. face 18" Oak
- S71°W - 60.93' Set nail w/remon. tag in N. face 26" Oak
- S72°E - 90.73' Set nail w/remon. tag above existing witness in N. face 16" Oak

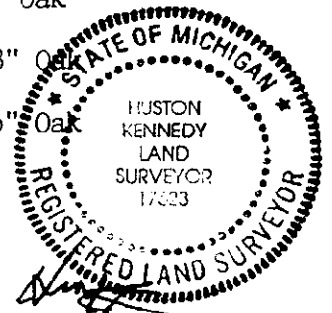

Signed by *Huston K. Kennedy*

Date 11/24/93

Surveyor's Michigan License No. 17623