

SURVEY &  
REMONUMENTATION

JUL 29 1998

REMONUMENTATION

RECEIVED FOR RECORD


98 JUL 27 PM 3: 54

SECTION

LAND CORNER RECORDATION CERTIFICATE  
Filing Requirement of Act 74, Mich. P.A. 1970

For corners in

Lapeer (County)	Located In: <u>Hudley</u> Township	Corner Code # <u>M-2</u>
1. Public Land Survey	T <u>6N</u> R <u>9E</u>	<u>Seg #2</u>
	T _____ R _____	_____
	T _____ R _____	_____
	T _____ R _____	_____
2. Property Controlling in Section	S _____ T _____ R _____	_____
	S _____ T _____ R _____	_____
3. Miscellaneous Property in Sec.	S _____ T _____ R _____	_____
	S _____ T _____ R _____	_____

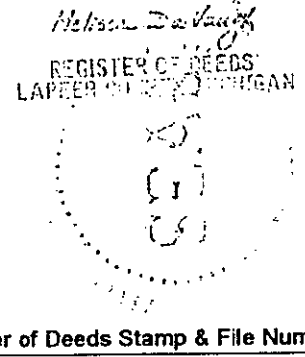

4. Lot No. \_\_\_\_\_, Recorded Plat \_\_\_\_\_  
5. Private Claims \_\_\_\_\_

I, Huston K. Kennedy, in a field survey on 8/5, 19 97 do hereby state that under requirements of P.A. 74, Michigan P.A. of 1970, the corner points mentioned in lines 1 and 2 above were in conformance with regulations and rules therefore as required in the current manual of survey instructions of the United States Department of the Interior, Bureau of Land Management or by a decree of a Court of Law and /or that the corner points mentioned in lines 3, 4 and 5 above were in conformance with the rules of the Michigan Board of Land Surveyors or by a Decree of a Court of Law; established, re-established, monumented, recovered, found as expressed below:

NOTE: Not more than 2 corners, all in the same town and range, may be recorded on this certificate.

	A	B	C	D	E	F	G	H	I	J	K	L	M
1													
2	6	5	4	3	2	1							
3													
4	7	8	9	10	11	12							
5													
6	18	17	16	15	14	13							
7													
8	19	20	21	22	23	24							
9													
10	30	29	28	27	26	25							
11													
12	31	32	33	34	35	36							
13													

A. Description of original monument and accessories and/or subsequent restoration:  
1817-GLO Carpenter, D.S., Set Post 10" Burr Oak N56°E 87 Links  
1.) 1994-Bates, PS #16699; Survey L.10, pg.337 - Fnd 1/2" Pipe

B. Description of corner evidence found and/or method applied in restoring or reestablishing corner:  
1997 Kennedy Surveying, Inc. - Kennedy, PS #17623 - Fnd 5/8" Iron Rod .80 feet below the surface in the existing centerline of Baldwin Road extending to the North & South, which has a gravel surface, and 3.00 feet South of the existing centerline of Farmers Creek Road extending to the East & West, which has a gravel surface. This corner is being used and accepted as a common corner with the West 1/4 corner of Section 6, T6N, R10E, Metamora Township (M-2).

Witnesses from Survey #1 were used to recover and verify the location of the found 5/8" Iron Rod.

I accepted the found 5/8" Iron Rod as the best evidence of the original corner position.

C. Description of monument for corner and accessories established to perpetuate locating the position of the corner:  
M-2 I replaced the found 5/8" Iron Rod with a 1/2" x 24" Iron Rod w/2" diameter brass cap stamped Lapeer County Remonumentation M-2  
N23°W 111.55' Set PK & Remon Washer NE face 31" Maple  
N45°E 63.58' SW corner of house #3245  
S47°W 66.55' NE corner of house #3252  
S46°E 59.91' Set PK & Remon Washer SW face 9" Cedar

The selected location is accepted by me and is generally accepted by Professional Surveyors as the best available evidence of the position of the original corner.

Signed by [Signature]  
Surveyor's Michigan License No. 17623

Date 7-14-98

