

SURVEY &  
REMONUMENTATION

JUL 29 1998

REMONUMENTATION

LAND CORNER RECORDATION CERTIFICATE  
Filing Requirement of Act 74, Mich. P.A. 1970

RECEIVED FOR RECORD

99 JUL 27 PM 3:55

SECTION

For corners in

Lapeer Located In: Corner Code #  
(County) Holley ~~Section~~ Township


1. Public Land Survey T 6N R 9E H-3  
T \_\_\_\_\_ R \_\_\_\_\_  
T \_\_\_\_\_ R \_\_\_\_\_ Seg #2  
T \_\_\_\_\_ R \_\_\_\_\_

2. Property Controlling S \_\_\_\_\_ T \_\_\_\_\_ R \_\_\_\_\_  
in Section S \_\_\_\_\_ T \_\_\_\_\_ R \_\_\_\_\_

3. Miscellaneous S \_\_\_\_\_ T \_\_\_\_\_ R \_\_\_\_\_  
Property in Sec. S \_\_\_\_\_ T \_\_\_\_\_ R \_\_\_\_\_

4. Lot No. \_\_\_\_\_, Recorded Plat \_\_\_\_\_

5. Private Claims \_\_\_\_\_

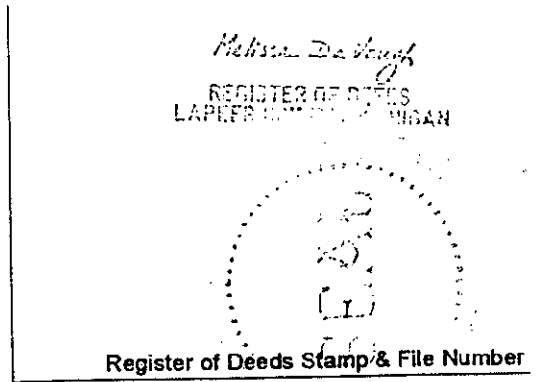

	A	B	C	D	E	F	G	H	I	J	K	L	M
1													
2	6		5		4		3		2		1		
3													
4	7		8		9		10		11		12		
5													
6	18		17		16		15		14		13		
7													
8	19		20		21		22		23		24		
9													
10	30		29		28		27		26		25		
11													
12	31		32		33		34		35		36		
13													

I, Huston K. Kennedy, in a field survey on 8/7, 19 97 do hereby state that under requirements of P.A. 74, Michigan P.A. of 1970, the corner points mentioned in lines 1 and 2 above were in conformance with regulations and rules therefore as required in the current manual of survey instructions of the United States Department of the Interior, Bureau of Land Management or by a decree of a Court of Law and/or that the corner points mentioned in lines 3, 4 and 5 above were in conformance with the rules of the Michigan Board of Land Surveyors or by a Decree of a Court of Law; established, re-established, monumented, recovered, found as expressed below:

NOTE: Not more than 2 corners, all in the same town and range, may be recorded on this certificate.

- A. Description of original monument and accessories and/or subsequent restoration:  
1817-GLO Carpenter, D.S., Set Post 16" Sugar N68°W 13 Links; 6" Beech S30°W 38 Links
- 1.) 1977-Henderson, PS #16043; Survey L.003, pg.957 - Fnd 1/2" Iron Rod in a Monument Box
  - 2.) 1977-Bates, PS #16699; Survey L.4, pg.390 - Object found not stated, used same wit as first recorded Certificate of Survey
  - 3.) 1985-Elrich, PS #16699; Survey L.6, pg.972 - 1/2" Iron Rod in a Monument Box, used same wit as first recorded Certificate of Survey
  - 4.) 1987-Carlson, PS #9189; Survey L.7, pg.539 - 1/2" Iron Rod in a Monument Box, used same wit as first recorded Certificate of Survey
  - 5.) 1994-Bates, PS #16699; Survey L.10, pg.337 - 1/2" Iron Rod

- B. Description of corner evidence found and/or method applied in restoring or reestablishing corner:  
1997 Kennedy Surveying, Inc. - Kennedy, PS #17623 - Fnd 1/2" Iron Rod in a Monument Box in the existing centerline of Baldwin Road extending to the North & South, which has a gravel surface, and 1.70 feet South of the existing centerline of Pratt Road extending to the East & West, which has a bituminous surface. This corner is being used and accepted and used as a common corner with Sections 6 & 7, T6N, R10E, Metamora Township (A-3).

Witnesses from Survey #5 were used to recover and verify the location of the found 1/2" Iron Rod in a Monument Box.

I accepted the found 1/2" Iron Rod in a Monument Box as the best evidence of the original corner position.

Field Measurements see back side of LCRC

- C. Description of monument for corner and accessories established to perpetuate locating the position of the corner:  
H-3 I replaced the found 1/2" Iron Rod with a 1/2" x 24" Iron Rod w/2" diameter brass cap stamped Lapeer County Remonumentation H-3 in a existing Monument Box  
N49°W 57.15' Set PK & Remon Washer SW face Power Pole  
N69°E 167.47' Set PK & Remon Washer SE face Power Pole  
S42°E 71.84' Set PK & Remon Washer SW face Light Pole  
S52°W 93.14' Set PK & Remon Washer SE face 12" Poplar

The selected location is accepted by me and is generally accepted by Professional Surveyors as the best available evidence of the position of the original corner.

Signed by [Signature]  
Surveyor's Michigan License No. 17623

Date 7-14-98

