

SURVEY &
REMONUMENTATION

MAR 13 1998

REMONUMENTATION

SECTION

LAND CORNER RECORDATION CERTIFICATE
Filing Requirement of Act 74, Mich. P.A. 1970

RECEIVED FOR RECORD
97 NOV 12 PM 3:07

For corners in

Lapeer

(County)

Located In:

Metamora Township

Corner Code #

- | | | | | | |
|------------------------------------|---|----|---|-----|-----|
| 1. Public Land Survey | T | 6N | R | 10E | A-2 |
| | T | | R | | |
| | T | | R | | |
| | T | | R | | |
| 2. Property Controlling in Section | S | | R | | |
| | S | | R | | |
| 3. Miscellaneous Property in Sec. | S | | R | | |
| | S | | R | | |

Melissa D. Vaughn
REGISTER OF DEEDS
LAPEER COUNTY, MICHIGAN

Register of Deeds Stamp & File Number

4. Lot No. _____, Recorded Plat _____
5. Private Claims _____

I, Huston K. Kennedy, in a field survey on 8/5, 1997 do hereby state that under requirements of P.A. 74, Michigan P.A. of 1970, the corner points mentioned in lines 1 and 2 above were in conformance with regulations and rules therefore as required in the current manual of survey instructions of the United States Department of the Interior, Bureau of Land Management or by a decree of a Court of Law and/or that the corner points mentioned in lines 3, 4 and 5 above were in conformance with the rules of the Michigan Board of Land Surveyors or by a Decree of a Court of Law; established, re-established, monumented, recovered, found as expressed below:

	A	B	C	D	E	F	G	H	I	J	K	L	M
1													
2	6	5	4	3	2	1							
3													
4	7	8	9	10	11	12							
5													
6	18	17	16	15	14	13							
7													
8	19	20	21	22	23	24							
9													
10	30	29	28	27	26	25							
11													
12	31	32	33	34	35	36							
13													

NOTE: Not more than 2 corners, all in the same town and range, may be recorded on this certificate.

A. Description of original monument and accessories and/or subsequent restoration:

- 1817-GLO Wampler, D.S., No post was set
- 1974-Henderson, PS #16043; LCRC L.2, pg.565 - Fnd 1/2" Iron Pipe
 - 1974-Kay, PS #14096; Survey L.2, pgs.972 & 973 - Fnd 1/2" Pipe
 - 1995-Gravlin, PS #23510; Survey L.10, pg.972 - Fnd 1/2" Pipe, used same wit as Survey #2
 - 1996-Gravlin, PS #23510; Survey L.11, pg.324 - Fnd 1/2" Pipe, used same wit as Survey #2
 - 1996-Kennedy, PS #17623; Unrecorded Survey - Fnd 1/2" Pipe

B. Description of corner evidence found and/or method applied in restoring or reestablishing corner:

1997 Kennedy Surveying, Inc. - Kennedy, PS #17623 - Fnd 5/8" Iron Rod .80 feet below the surface in the existing centerline of Baldwin Road extending to the North & South, which has a gravel surface, and 3.00 feet South of the existing centerline of Farmers Creek Road extending to the East & West, which has a gravel surface. This corner is being used and accepted as a common corner with the East 1/4 corner of Section 1, T6N, R9E, Hadley Township (M-3).


Witnesses from LCRC #1 & Survey #2 were used to recover and verify the location of the found 5/8" Iron Rod.

I accepted the found 5/8" Iron Rod as the best evidence of the original corner position.

C. Description of monument for corner and accessories established to perpetuate locating the position of the corner:

- A-2 I replaced the found 5/8" Iron Rod with a 1/2" x 24" Iron Rod w/2" diameter brass cap stamped Lapeer County Remonumentation #2
- N23°W 111.55' Set PK & Remon Washer NE face 31" Maple
 - N45°E 63.58' SW corner of house #3245
 - S47°W 66.55' NE corner of house #3252
 - S46°E 59.91' Set PK & Remon Washer SW face 9" Cedar

The selected location is accepted by me and is generally accepted by Professional Surveyors as the best available evidence of the position of the original corner.

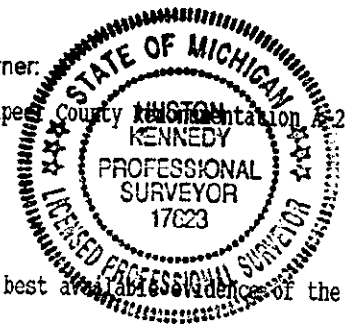

Signed by Huston K. Kennedy
Surveyor's Michigan License No. 17623

Date 9-30-97


FIELD MEASUREMENTS BETWEEN

A-2 to A-1

No GLO
GROUND-MEA = 2817.90 Ft.

A-2 to A-3

No GLO
Unrecorded Survey by Kennedy, PS #17623 (3/1/96) = 2681.73 Ft.
GROUND-MEA = 2681.93 Ft.

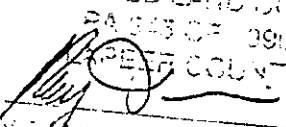TRIP GROUP
APPROVED LAND CORNER
PAGE 02 OF 090
PETE COUNTY

DAVID E. VIS P. S. CO. SURVEYOR
DATE 9-29-97