

MAR 29 1999

REMONUMENTATION

SECTION

LAND CORNER RECORDATION CERTIFICATE
Filing Requirement of Act 74, Mich. P.A. 1970

For corners in

Lapeer
(County)

Located In: Metamora Township Corner Code #

RECEIVED FOR RECORD

98 DEC 22 PM 3:34

Melissa DeVaugh
REGISTER OF DEEDS
LAPEER COUNTY MICHIGAN

419

Register of Deeds Stamp & File Number

1. Public Land Survey	T6N	R10E	A-6
	T	R	
	T	R	
	T	R	
2. Property Controlling in Section	S	T	R
	S	T	R
3. Miscellaneous Property in Sec.	S	T	R
	S	T	R

4. Lot No. _____ Recorded Plat _____
5. Private Claims _____

A	B	C	D	E	F	G	H	I	J	K	L	M
1												
2	6	5	4	3	2							
3												
4	7	8	9	10	11	12						
5												
6	18	17	16	15	14	13						
7												
8	19	20	21	22	23	24						
9												
10	30	29	28	27	26	25						
11												
12	31	32	33	34	35	36						
13												

I, Huston K. Kennedy, in a field survey on July 29, 1998 do hereby state that under requirements of P.A. 74, Michigan P.A. of 1970, the corner points mentioned in lines 1 and 2 above were in conformance with regulations and rules therefore as required in the current manual of survey instructions of the United States Department of the Interior, Bureau of Land Management or by a decree of a Court of Law and/or that the corner points mentioned in lines 3, 4 and 5 above were in conformance with the rules of the Michigan Board of Land Surveyors or by a Decree of a Court of Law; established, re-established, monumented, recovered, found as expressed below:

NOTE: Not more than 2 corners, all in the same town and range, may be recorded on this certificate.


- A. Description of original monument and accessories and/or subsequent restoration:
 - 1817-GLO Wampler, D.S.; No post was set
 - 1) 1972-Elrich, PS #18986; LCRC L.1, Pg.351 - Fnd a Iron
 - 2) 1994-Kennedy, PS #17623; LCRC for M-6 Hadley Twp., L.5, Pg.129 - Fnd 1/2" Iron Rod
 - 3) 1972-Kay, PS #14096; Survey L.1, Pg.422 - Object found not stated
 - 4) 1972-Elrich, PS #18986; Survey L.1, Pgs.473 & 474 - Fnd Iron Rod, used same wit as 1972 LCRC
 - 5) 1975-Elrich, PS #18986; Survey L.3, Pg.315 - Fnd 3/8" Iron, used same wit as 1972 LCRC
 - 6) 1994-Kennedy, PS #17623; Unrecorded Survey - Fnd a 1/2" Iron Rod
- B. Description of corner evidence found and/or method applied in restoring or reestablishing corner:
 - 1998-Kennedy Surveying, Inc. - Kennedy, PS #17623 - Fnd a 1/2" Iron Rod 1 foot below the road surface and located in the existing centerline of Baldwin Road extending to the North & South, which has a gravel surface. Also located in the existing centerline of Kile Road extending to the East, which has a gravel surface. The corner as recovered is 0.11 feet East of the range line. West 1/4 corner of Section 13, T6N, R9E, Hadley Township (M-6) is located 78.18 feet to the North. Also found a 1/2" Iron Rod 6.80 feet to the West.

Witnesses from LCRC #1 & Survey #3 were used to recover and verify the location of the found 1/2" Iron Rod.

I accepted the found 1/2" Iron Rod as the best evidence of the original corner position.

Field measurements see back side of LCRC

- C. Description of monument for corner and accessories established to perpetuate locating the position of the corner:
 - A-6 I replaced the found 1/2" Iron Rod with a 1/2" x 24" Iron Rod w/2" diameter brass cap stamped Lapeer County
 - Remonumentation, PS #17623
 - Due West 44.59' NE corner of house #4250
 - S69°E 101.32' Set Mag Nail & Remon Washer SW face 29" Oak
 - N25°E 72.15' Set Mag Nail & Remon Washer NW face 32" Oak
 - N67°E 111.00' SW corner of garage w/house #4245
 - North 78.18 feet, West 1/4 corner of Section 13, T6N, R9E, Hadley Township (M-6)

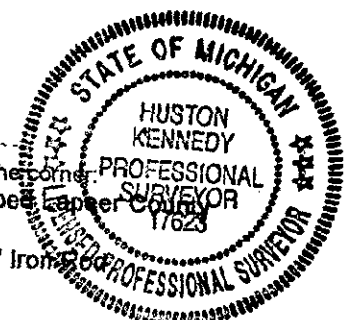

The selected location is accepted by me and is generally accepted by Professional Surveyors as the best available evidence of the position of the original corner.

Signed by: [Signature] Date 9-25-98
Surveyor's Michigan License No. 17623

MAR 29 1999

SECTION

FIELD MEASUREMENTS BETWEEN

A-6 to A-5

No GLO
Survey recorded in Liber 001, page 422 = 2650.54 Ft.
Unrecorded Survey by Kennedy, PS #17623 = 2648.25 Ft.
2648.16 Ft. (MEA 1998)


A-6 to A-7

No GLO
Survey recorded in Liber 001, pages 473 & 474 = 2631.20 Ft.
2630.39 Ft. (MEA 1998)

A-6 to M-6

No GLO
Survey recorded in Liber 3, page 315 = 78.22 Ft., LCRC Liber 5, page 129 = 78.18 Ft.
78.18 Ft. (MEA 1998)

MISC D	9.00
REMLC	F0075
REMONT	2.00

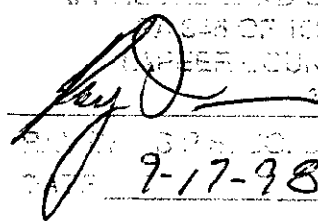PEER GROUP
APPROVED LAND CORNER
MAY 28 1998
PEER COUNTY

SUPERVISOR
DATE 9-17-98