

SURVEY & REMONUMENTATION

MAR 13 1998

**REMONUMENTATION
LAND CORNER RECORDATION CERTIFICATE
Filing Requirement of Act 74, Mich. P.A. 1970**

RECEIVED FOR RECORD

97 AUG 11 PM 2:25

Melissa D. Vaughn
REGISTERED PROFESSIONAL
LAND SURVEYOR

Register of Deeds Stamp & File Number

For corners in

<u>Lapeer</u> (County)	Located In: <u>Metamora Township</u>	Corner Code # <u>D-2</u>
1. Public Land Survey	T <u>6N</u> R <u>10E</u>	<u> </u>
	T <u> </u> R <u> </u>	<u> </u>
	T <u> </u> R <u> </u>	<u> </u>
	T <u> </u> R <u> </u>	<u> </u>
2. Property Controlling in Section	S <u> </u> T <u> </u> R <u> </u>	<u> </u>
	S <u> </u> T <u> </u> R <u> </u>	<u> </u>
3. Miscellaneous Property in Sec.	S <u> </u> T <u> </u> R <u> </u>	<u> </u>
	S <u> </u> T <u> </u> R <u> </u>	<u> </u>

4. Lot No. _____, Recorded Plat _____
5. Private Claims _____

I, Huston K. Kennedy, in a field survey on 6/27, 19 97 do hereby state that under requirements of P.A. 74, Michigan P.A. of 1970, the corner points mentioned in lines 1 and 2 above were in conformance with regulations and rules therefore as required in the current manual of survey instructions of the United States Department of the Interior, Bureau of Land Management or by a decree of a Court of Law and /or that the corner points mentioned in lines 3, 4 and 5 above were in conformance with the rules of the Michigan Board of Land Surveyors or by a Decree of a Court of Law; established, re-established, monumented, recovered, found as expressed below:

NOTE: Not more than 2 corners, all in the same town and range, may be recorded on this certificate.

	A	B	C	D	E	F	G	H	I	J	K	L	M
1													
2	6			●		4		3		2		1	
3													
4	7		8		9		10		11		12		
5													
6	13		17		16		15		14		13		
7													
8	19		20		21		22		23		24		
9													
10	30		29		28		27		26		25		
11													
12	31		32		33		34		35		36		
13													

A. Description of original monument and accessories and/or subsequent restoration:

- 1822-GLO Wampler, D.S., Post not set, No Witnesses Trees
- 1973-Henderson, PS #16043; Survey L.1, Pg.949 - Fnd ?, No Witnesses
 - 1974-Kay, PS #14096; Survey L.2, Pg.567 - Set P.K. Nail
 - 1974-Kay, PS #14096; Survey L.2, Pg.568 - Fnd P.K. Nail, used same wit as 1974 Survey
 - 1974-Kay, PS #14096; Survey L.2, Pg.569 - Fnd P.K. Nail, used same wit as 1974 Survey
 - 1978-Henderson, PS #16043; Survey L.4, Pg.709 - Fnd ?
 - 1979-Elrich, PS #18986; Survey L.5, Pg.67 - Fnd P.K. Nail, used same wit as 1978 Survey
 - 1981-Bates, PS #16699; Survey L.5, Pg.961 - Fnd P.K. Nail, used same wit as 1978 Survey
 - 1981-Bates, PS #16699; Survey L.5, Pg.963 - Fnd P.K. Nail, used same wit as 1978 Survey
 - 1981-Bates, PS #16699; Survey L.5, Pg.993 - Fnd P.K. Nail, used same wit as 1978 Survey (over)

B. Description of corner evidence found and/or method applied in restoring or reestablishing corner:

1996 Kennedy Surveying, Inc. - Kennedy, PS #17623 - Fnd P.K. Nail .3 feet West of the existing centerline of Lapeer Road (M-24 Highway) extending to the North & South, which has a bituminous surface over a concrete base. There is a fence-tree line 81 feet to the South extending to the East.

Witnesses from Survey #2 were used to recover and verify the location of the found P.K. Nail.

I accepted the found P.K. Nail as the best evidence of the position of the corner as being accepted and used.

Field Measurements see back side of LCRC

C. Description of monument for corner and accessories established to perpetuate locating the position of the corner:

- D-2 I replaced the found P.K. Nail with a 1/2" x 18" Iron Rod w/2" diameter brass cap stamped Lapeer County Remonumentation #17623 in a new Monument Box
- S22°E 197.40' Set PK & Remon Washer SW face Power Pole
 - N36°E 106.52' Set PK & Remon Washer SE face Power Pole
 - S41°W 85.41' Set PK & Remon Washer SE face 10" Elm
 - S78°W 64.64' Set PK & Remon Washer South face 5" Cherry

The selected location is accepted by me and is generally accepted by Professional Surveyors as the best available evidence of the position of the corner as being accepted and used.

Signed by *[Signature]*
Surveyor's Michigan License No. 17623

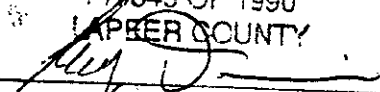
Date 7-1-97



FIELD MEASUREMENTS BETWEEN

D-2 to D-1 No GLO, 2839.97 Ft. (MEA 1996) 2840.72 Ft. L.5, Pg.961, L.5, Pg.943
D-2 to D-3 No GLO, 2639.12 Ft. (MEA 1996) 2640.00 Ft., L.2, Pg.567 & L.2, Pg.569
N 534947.4002, E 1305007.3796

PEER GROUP
APPROVED LAND CORNER
PA 345 OF 1990
LAPPEER COUNTY


RAY DAVIS P.S. CO. SURVEYOR
DATE 8-27-96

PRICE \$ 1.00
TOTAL POINTS
REMARK 2.00