

**SURVEY &
REMONUMENTATION**

MAR 1 9 1998


SECTION

**REMONUMENTATION
LAND CORNER RECORDATION CERTIFICATE
Filing Requirement of Act 74, Mich. P.A. 1970**

RECEIVED FOR RECORD
97 AUG 11 PM 2:31

For corners in

<u>Lapeer</u> (County)	Located In: <u>Metamora Township</u>	Corner Code # <u>D-7</u>
1. Public Land Survey	T <u>6N</u> R <u>10E</u>	<u>D-7</u>
	T <u> </u> R <u> </u>	<u> </u>
	T <u> </u> R <u> </u>	<u> </u>
	T <u> </u> R <u> </u>	<u> </u>
2. Property Controlling in Section	S <u> </u> T <u> </u> R <u> </u>	<u> </u>
	S <u> </u> T <u> </u> R <u> </u>	<u> </u>
3. Miscellaneous Property in Sec.	S <u> </u> T <u> </u> R <u> </u>	<u> </u>
	S <u> </u> T <u> </u> R <u> </u>	<u> </u>

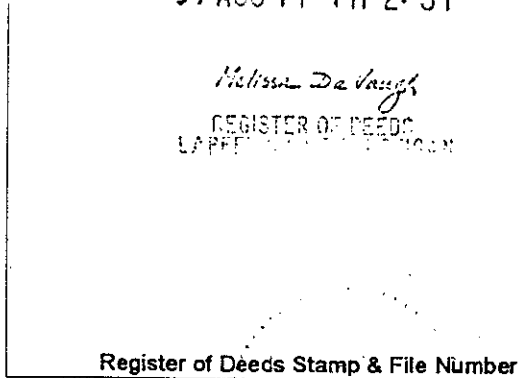

4. Lot No. _____, Recorded Plat _____
5. Private Claims _____

I, Huston K. Kennedy, in a field survey on 6/27, 19 97 do hereby state that under requirements of P.A. 74, Michigan P.A. of 1970, the corner points mentioned in lines 1 and 2 above were in conformance with regulations and rules therefore as required in the current manual of survey instructions of the United States Department of the Interior, Bureau of Land Management or by a decree of a Court of Law and /or that the corner points mentioned in lines 3, 4 and 5 above were in conformance with the rules of the Michigan Board of Land Surveyors or by a Decree of a Court of Law; established, re-established, monumented, recovered, found as expressed below:

A	B	C	D	E	F	G	H	I	J	K	L	M
1												
2	6		5		4		3		2		1	
3												
4	7		8		9		10		11		12	
5												
6	18		17		16		15		14		13	
7												
8	19		20		21		22		23		24	
9												
10	30		29		28		27		26		25	
11												
12	31		32		33		34		35		36	
13												

NOTE: Not more than 2 corners, all in the same town and range, may be recorded on this certificate.

- A. Description of original monument and accessories and/or subsequent restoration:
1822-GLO Wampler, D.S., Set Post 12" White Oak S57°W 63. Links; 6" Aspen S40°E 58 Links
1.) 1972-Henderson, PS #16043; LCRC L.1, Pg.465 - Fnd P.K. Nail & Tag
2.) 1986- Kennedy, PS #17623; LCRC L.4, Pg.114 - Fnd P.K. Nail
3.) 1987-Kennedy, PS #17623; Unrecorded Survey - Fnd P.K. Nail, used same wit as 1986 LCRC
4.) Information received from Lapeer County Road Commission - Set Monument Box

- B. Description of corner evidence found and/or method applied in restoring or reestablishing corner:
1996 Kennedy Surveying, Inc. - Kennedy, PS #17623 - Fnd P.K. Nail 6.5 feet East of the existing centerline of Lapeer Road (M-24 Highway), which has a bituminous surface over a concrete base extending to the North & South, and 3 feet North of the existing centerline of Best Road, which has a gravel surface extending to the West. A fence-tree row extending to the East.

Witnesses from LCRC #2 were used to recover and verify the location of the found P.K. Nail.

I accepted the found P.K. Nail as the best evidence of the original corner position.

- C. Description of monument for corner and accessories established to perpetuate locating the position of the corner:

D-7 I replaced the found P.K. Nail with a 1/2" x 18" Iron Rod w/2" diameter brass cap stamped Lapeer County Remonumentation #17623 in a new Monument Box
N87°E 51.06' Set PK & Remon Washer North face Power Pole
S53°W 81.91' Set PK & Remon Washer SE face Power Pole
N38°E 102.82' NE corner of building
N76°W 139.03' Set PK & Remon Washer South face 26" Maple

The selected location is accepted by me and is generally accepted by Professional Surveyors as the best available evidence of the position of the original corner.

Signed by [Signature]
Surveyor's Michigan License No. 07623

Date 7-1-97




LIBER 0005 PAGE 0426

FIELD MEASUREMENTS BETWEEN

D-7 to D-6 No GLO, 2646.97 Ft. (NEA 1996) 2647.75 Ft. (NEA 1987)
D-7 to D-8 No GLO, 2643.36 Ft. (NEA 1996)
N 521691.9309, E 13405543.7239

PEER GROUP
APPROVED LAND CORNER
PA 345 OF 1990
DEER COUNTY

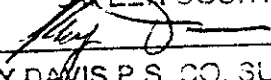
RAY DAVIS P.S. CO. SURVEYOR
DATE 7-16-96

FIELD 0 0.00
REMARKS 00075
REMARK 1.00