

SURVEY &  
REMONUMENTATION

MAR 13 1998

SECTION

REMONUMENTATION  
LAND CORNER RECORDATION CERTIFICATE  
Filing Requirement of Act 74, Mich. P.A. 1970

RECEIVED FOR RECORD

97 AUG 11 PM 2:32

For corners in

<u>Lapeer</u> (County)	Located in: <u>Metamora Township</u>	Corner Code # <u>D-8</u>
1. Public Land Survey	T <u>6N</u> R <u>10E</u>	<u>D-8</u>
	T <u>   </u> R <u>   </u>	<u>   </u>
	T <u>   </u> R <u>   </u>	<u>   </u>
	T <u>   </u> R <u>   </u>	<u>   </u>
2. Property Controlling in Section	S <u>   </u> T <u>   </u> R <u>   </u>	<u>   </u>
	S <u>   </u> T <u>   </u> R <u>   </u>	<u>   </u>
3. Miscellaneous Property in Sec.	S <u>   </u> T <u>   </u> R <u>   </u>	<u>   </u>
	S <u>   </u> T <u>   </u> R <u>   </u>	<u>   </u>

Melissa DeVaugh  
REGISTER OF DEEDS  
LAPEER COUNTY MICHIGAN

Register of Deeds Stamp & File Number

4. Lot No. \_\_\_\_\_, Recorded Plat \_\_\_\_\_  
5. Private Claims \_\_\_\_\_

I, Huston K. Kennedy, in a field survey on 6/27, 19 97 do hereby state that under requirements of P.A. 74, Michigan P.A. of 1970, the corner points mentioned in lines 1 and 2 above were in conformance with regulations and rules therefore as required in the current manual of survey instructions of the United States Department of the Interior, Bureau of Land Management or by a decree of a Court of Law and/or that the corner points mentioned in lines 3, 4 and 5 above were in conformance with the rules of the Michigan Board of Land Surveyors or by a Decree of a Court of Law; established, re-established, monumented, recovered, found as expressed below:

NOTE: Not more than 2 corners, all in the same town and range, may be recorded on this certificate.

1	A	B	C	D	E	F	G	H	I	J	K	L	M
2		6		5		4		3		2		1	
3													
4		7		8		9		10		11		12	
5													
6		10		17		16		15		14		13	
7													
8		19		20		21		22		23		24	
9													
10		30		29		28		27		26		25	
11													
12		31		32		33		34		35		36	
13													

A. Description of original monument and accessories and/or subsequent restoration:  
1822-GLO Wampler, D.S., No Post Set  
1.) 1977-Kay, PS #14096; Survey L.4, Pg.328 - Fnd Railroad Spike

B. Description of corner evidence found and/or method applied in restoring or reestablishing corner:  
1996 Kennedy Surveying, Inc. - Kennedy, PS #17623 - Fnd Railroad Spike 4" below the surface and 28.70 feet East of the existing centerline of Lapeer Road (M-24 Highway) extending to the North & South, which has a bituminous surface over a concrete base. There is a fence-tree line extending to the East & West. D-8 is also the Northwest corner of "NETAMORA MEADOWS" a plat recorded in Liber 2 of Plat, on page 32 of Lapeer County Records.

Witnesses from Survey #1 were used to recover and verify the location of the found Railroad Spike.  
I accepted the found Railroad Spike as the best evidence of the corner position as being accepted and used.

C. Description of monument for corner and accessories established to perpetuate locating the position of the corner:  
D-8 I replaced the found Railroad Spike with 4" diameter Concrete Monument 36" long with 1/2" Iron Rod w/2" diameter brass cap stamped Lapeer County Remonumentation #17623  
Due West 74.62' Set PK & Remon Washer South face 42" Oak  
S30°W 177.28' Set PK & Remon Washer SE face Power Pole  
S41°E 45.42' Set PK & Remon Washer NE face Power Pole  
N13°E 147.19' Set PK & Remon Washer West face 16" Elm

The selected location is accepted by me and is generally accepted by Professional Surveyors as the best available evidence of the position of this corner.

Signed by Huston K. Kennedy  
Surveyor's Michigan License No. 17623

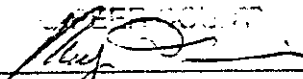
Date 7-1-97



FIELD MEASUREMENTS BETWEEN

D-8 to D-7 No GLO, 2636.82 Ft. (MEA 1996)  
D-8 to D-9 No GLO, 2643.36 Ft. (MEA 1996)  
N 519057.3574, E 13405658.3297

PEER GROUP  
APPROVED LINDA H. HARRIS  
IN PLACE OF  
COURT

  
RAY DAVIS P.S. CO. SURVEYOR  
DATE 7-16-96

ISSUED 7/16/96  
BY RAY DAVIS  
REVISION 000