

**SURVEY &  
REMONUMENTATION**

MAY 28 1997

COMMISSION

REMONUMENTATION

LAND CORNER RECORDATION CERTIFICATE  
Filing Requirement of Act 74, Mich. P.A. 1970

RECEIVED FOR RECORD

97 JAN 13 PM 2:46

For corners in

<u>LAPEER</u> (County)	Located In:	Corner Code #
1. Public Land Survey	T <u>6N</u> R <u>10E</u>	<u>K-1</u>
METAMORA TOWNSHIP	T _____ R _____	_____
	T _____ R _____	_____
	T _____ R _____	_____
2. Property Controlling in Section	S _____ T _____ R _____	_____
	S _____ T _____ R _____	_____
3. Miscellaneous Property in Sec.	S _____ T _____ R _____	_____
	S _____ T _____ R _____	_____

*Melissa DeVaugh*  
REGISTER OF DEEDS  
LAPEER COUNTY

Register of Deeds Stamp & File Number

4. Lot No. \_\_\_\_\_, Recorded Plat \_\_\_\_\_  
5. Private Claims \_\_\_\_\_

I, HAROLD N. ELRICH, in a field survey on APRIL 11, 19 96, do hereby certify that under requirements of P.A. 74, Michigan P.A. of 1970, the corner points mentioned in lines 1 and 2 above were in conformance with regulations and rules therefore as required in the current manual of survey instructions of the United States Department of the Interior, Bureau of Land Management or by a decree of a Court of Law and/or that the corner points mentioned in lines 3, 4 and 5 above were in conformance with the rules of the Michigan Board of Land Surveyors or by a Decree of a Court of Law; established, re-established, monumented, re-monumented, recovered, found as expressed below:

**NOTE: Not more than 4 corners, all in the same town and range, may be recorded on this certificate.**

A. Description of original monument and accessories and/or subsequent restoration:

JOSEPH WAMPLER - NO POST SET - CREEK  
1972 HENDERSON, BATES & ELRICH, INC., JOB #6292, NOV 11, 1972

A	B	C	D	E	F	G	H	I	J	K	L	M
2	6	5	4	3	2	1						
3												
4	7	8	9	10	11	12						
5												
6	18	17	16	15	14	13						
7												
8	19	20	21	22	23	24						
9												
10	30	29	28	27	26	25						
11												
12	31	32	33	34	35	36						
13												

PEER GROUP  
APPROVED LAND CORNER  
PA 345 OF 1990  
LAPEER COUNTY

*Ray Davis*  
RAY DAVIS P.S. CO. SURVEYOR  
DATE 9-10-96

B. Description of corner evidence found and/or method applied in restoring or reestablishing corner:

1996 HAROLD N. ELRICH P.S. #18986 SET 1/2" IRON & REMONUMENTATION CAP IN CENTERLINE OF SUTTON ROAD (GRAVEL) WITH NO OCCUPATION SOUTH. RE-SET CORNER AS SHOWN IN UNRECORDED SURVEY BY HENDERSON, BATES & ELRICH, INC., JOB #6292, NOV 11, 1972

ACCEPTED 1/2" IRON AS BEST LOCATION OF ORIGINAL POSITION OF NORTHWEST CORNER OF SECTION 1, T6N-R10E, METAMORA TOWNSHIP, LAPEER COUNTY, MICHIGAN

MEASURED REFERENCES - K-1 TO K-13 (SOUTHEAST CORNER, SEC. 35, T7N-R10E) 1265.75 FEET


RE-SET CORNER AS SHOWN IN UNRECORDED SURVEY BY HENDERSON, BATES & ELRICH, INC., JOB #6292, NOV 11, 1972

C. Description of monument for corner and accessories established to perpetuate locating the position of the corner:

K-1 PLACED LAPEER COUNTY REMONUMENTATION CAP ON 1/2" IRON

SET NEW WITNESSES - N 45° W 20.03 FEET P.K. NAIL & WASHER IN GUARD POST  
N 20° E 18.21 FEET P.K. NAIL & WASHER IN GUARD POST  
S 45° E 16.22 FEET P.K. NAIL & WASHER IN GUARD POST  
S 45° W 17.68 FEET P.K. NAIL & WASHER IN GUARD POST

Signed by *Harold N. Elrich*  
Surveyor's Michigan License No. 18986

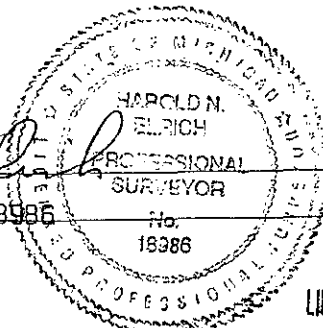

Date 12-30-96