

SURVEY & REMONUMENTATION

OCT 29 1996

COMMISSION

Remonumentation
LAND CORNER RECORDATION CERTIFICATE
 Filing Requirement of Act 74, Mich. P.A. 1970

RECEIVED FOR RECORD
 96 SEP 30 PM 3:22

For corners in

LAPEER
 (County)

Located In METAMORA TWP. Corner Code #

- | | | | | | |
|--------------------------------------|---|-----------|---|------------|------------|
| 1. Public Land Survey | T | <u>6N</u> | R | <u>10E</u> | <u>K-4</u> |
| | T | _____ | R | _____ | _____ |
| | T | _____ | R | _____ | _____ |
| | T | _____ | R | _____ | _____ |
| 2. Property Controlling in Section | S | _____ | T | _____ | R |
| | S | _____ | T | _____ | R |
| 3. Miscellaneous Property in Section | S | _____ | T | _____ | R |
| | S | _____ | T | _____ | R |
4. Lot No. _____, Recorded Plat _____
5. Private Claims _____

Houston K. Kennedy
 REGISTERED PROFESSIONAL SURVEYOR
 LAPEER COUNTY MICHIGAN

Register of Deeds Stamp & File Number


A	B	C	D	E	F	G	H	I	J	K	L	M
2	6	5	4	3	2							
3												
4	7	8	9	10	11							
5												
6	18	17	16	15	14	13						
7												
8	19	20	21	22	23	24						
9												
10	30	29	28	27	26	25						
11												
12	31	32	33	34	35	36						
13												

I, Huston K. Kennedy, in a field survey on June 4, 19 96, do hereby certify that under requirements of P.A. 74, Michigan P.A. of 1970, the corner points mentioned in lines 1 and 2 above were in conformance with regulations and rules therefore as required in the current manual of survey instructions of the United States Department of the Interior, Bureau of Land Management or by a decree of a Court of Law and/or that the corner points mentioned in lines 3, 4 and 5 above were in conformance with the rules of the Michigan Board of Professional Surveyors or by a Decree of a Court of Law; established, re-established, monumented, re-monumented, recovered, found as expressed below:

NOTE: Not more than 4 corners, all in the same town and range, may be recorded on this certificate.

A. Description of original monument and accessories and/or subsequent restoration:

- 1817-GLO Joseph Wampler, D.S.; Set Post; 20" Black Oak S05°E 19 Links; 20" Black Oak N44°W 17 Links
 1.) 1976-Elrich, PS #18986; LCRC, L.3, Pg.205 - Fnd 1/2" Iron
 2.) 1977-Elrich, PS #18986; Unrecorded Survey - Fnd 1/2" Iron Rod, used same wit as 1976 LCRC

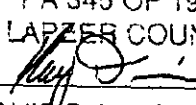PEER GROUP
 APPROVED LAND CORNER
 PA 345 OF 1990
 LAPEER COUNTY

 RAY DAVIS P.S. CO. SURVEYOR
 DATE 7-16-96

B. Description of corner evidence found and/or method applied in restoring or reestablishing corner:

1996-Kennedy Survey, Inc. - Kennedy, P.S. #17623 - Fnd 1/2" Iron Rod at the surface in the center of lane extending East & West with a fence line extending East & West 18 feet North & South of Iron Rod.

Witnesses from LCRC #1 were used to recover and verify the location of the found 1/2" Iron Rod.

I accepted the found 1/2" Iron Rod as the best evidence of the original corner position.

FIELD MEASUREMENTS BETWEEN


- K-5 to K-4 GLO = 40 chains or 2640.00 Ft.
 K-5 to K-4 2773.54 Ft. Unrecorded Survey by Elrich, PS #18986
 L-5 to K-4 2772.46 Ft. (MEA)
 N 530381.2920 E 13423667.1690

C. Description of monument for corner and accessories established to perpetuate locating the position of the corner:

- K-4 I replaced the found 1/2" Iron Rod with a 1/2" x 24" Iron Rod w/2" diameter brass cap stamped Lapeer County Remonumentation K-4
 S11°E 15.40' Set PK & Remon. Washer West face 8" Cherry
 N41°W 23.30' Set PK & Remon. Washer SW face 10" Ash
 Due South 26.85' Set PK & Remon. Washer West face 41" Oak
 N38°E 24.24' Set PK & Remon. Washer NW face 8" Oak

The selected location is accepted by me and is generally accepted by Professional Surveyors as the position of the original corner.

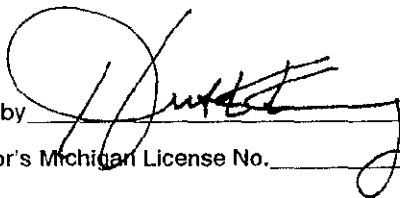

Signed by 

Date July 17, 1996

Surveyor's Michigan License No. 17623

FORM APPROVED BY MICHIGAN STATE BOARD OF PROFESSIONAL SURVEYORS, JAN. 28, 1971
 REVISED MAY 14, 1975
 REVISED JAN., 1983