

MAY 28 1997

COMMISSION

REMONUMENTATION LAND CORNER RECORDATION CERTIFICATE Filing Requirement of Act 74, Mich. P.A. 1970

RECEIVED FOR RECORD 97 JAN 13 PM 2:42

For corners in

Table with columns: LAPEER (County), Located In: (T, R), Corner Code: # (M-1). Rows include Public Land Survey, Property Controlling in Section, and Miscellaneous Property in Sec.

Melissa DeVaugh REGISTER OF DEEDS LAPEER COUNTY MICHIGAN

Register of Deeds Stamp & File Number

4. Lot No. , Recorded Plat
5. Private Claims

Grid table with columns A-M and rows 2-13, containing numbers 1-36.

I, HAROLD N. ELRICH, in a field survey on APRIL 11, 1996, do hereby certify that under requirements of P.A. 74, Michigan P.A. of 1970, the corner points mentioned in lines 1 and 2 above were in conformance with regulations and rules therefore as required in the current manual of survey instructions of the United States Department of the Interior, Bureau of Land Management or by a decree of a Court of Law and/or that the corner points mentioned in lines 3, 4 and 5 above were in conformance with the rules of the Michigan Board of Land Surveyors or by a Decree of a Court of Law; established, re-established, monumented, re-monumented, recovered, found as expressed below:

NOTE: Not more than 4 corners, all in the same town and range, may be recorded on this certificate.

A. Description of original monument and accessories and/or subsequent restoration: JOSEPH WAMPLER D.S. SET POST - WHITE OAK 8" N 55° E 53 LINKS, B.O. 9" N 48° W 25 LINKS 1980 LELAND D. BATES P.S. #16699 (SURVEY) LIBER 006, PAGES 128 & 129, S 45° E 61.22 FEET 40" MAPLE, S 50° W 43.33 FEET 24" OAK, N 30° W 33.05 FEET 18" OAK 1980 LELAND D. BATES P.S. #16699 (LAND CORNER RECORDATION CERTIFICATE) FOUND IRON LIBER 004, PAGE 21, S 45° E 61.22 FEET 40" MAPLE, S 50° W 43.33 FEET 24" OAK, N 30° W 33.05 FEET 18" OAK 1984 HAROLD N. ELRICH P.S. #18986 (SURVEY) LIBER 006, PAGE 828 - FOUND 1/2" IRON N 10° E 37.90 FEET TELEPHONE POLE, S 60° W 43.32 FEET 20" OAK, S 30° E 61.32 FEET 36" MAPLE N 30° W 33.00 FEET 12" OAK

(SEE BACK)

B. Description of corner evidence found and/or method applied in restoring or reestablishing corner: 1996 HAROLD N. ELRICH P.S. #18986 FOUND 1/2" IRON - STRAIGHT - ON WEST EDGE OF THORNVILLE ROAD AND SOUTH EDGE OF SUTTON ROAD. FOUND TWO WITNESSES FROM PREVIOUS SURVEYS THAT LOCATE THE 1/2" IRON FOUND.

ACCEPTED 1/2" IRON FOUND AS BEST LOCATION OF ORIGINAL POSITION OF NORTHEAST CORNER OF SECTION 1, T6N-R10E, METAMORA TOWNSHIP, LAPEER COUNTY, MICHIGAN


MEASURED REFERENCES - M-1 TO L-1 2737.62 FEET M-1 TO B-1 2637.14 FEET (N 1/4 COR. SEC. 6, T6N-R11E, DRYDEN) M-1 TO M-2 2836.59

C. Description of monument for corner and accessories established to perpetuate locating the position of the corner:

M-1 PLACED LAPEER COUNTY REMONUMENTATION CAP ON 1/2" IRON FOUND

SET NEW WITNESSES - N 40° E 36.06 FEET P.K. NAIL & WASHER IN 14" OAK S 45° E 61.22 FEET P.K. NAIL & WASHER IN 40" MAPLE S 50° W 43.33 FEET P.K. NAIL & WASHER IN 24" OAK N 30° W 32.90 FEET P.K. NAIL & WASHER IN 18" OAK

Signed by Harold N. Elrich Surveyor's Michigan License No. 18986 No. 18986

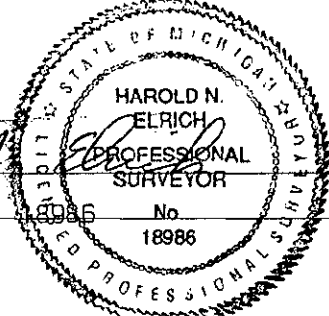

Date Dec. 17, 1996

SURVEY &
REMONUMENTATION

MAY 28 1997

COMMISSION

1986 HAROLD N. ELRICH P.S. #18986 (SURVEY) FOUND 1/2" IRON
LIBER 007, PAGE 238 - SAME WITNESSES AS PREVIOUS SURVEY

1989 HAROLD N. ELRICH P.S. #18986 (SURVEY) FOUND 1/2" IRON
LIBER 008, PAGE 196 - SAME WITNESSES AS PREVIOUS SURVEY

1989 HAROLD N. ELRICH P.S. #18986 (SURVEY) FOUND 1/2" IRON
LIBER 008, PAGE 400 - SAME WITNESSES AS PREVIOUS SURVEY

PEER GROUP
APPROVED LAND CORNER
PA 345 OF 1990
LATEER COUNTY

Ray Davis
RAY DAVIS P. S. CO. SURVEYOR
DATE 9-10-96

MISC D 9.00
REMLC F0075
REMONT 2.00