

MAR 13 1998

SECTION

REMONUMENTATION

RECEIVED FOR RECORD

LAND CORNER RECORDATION CERTIFICATE
Filing Requirement of Act 74, Mich. P.A. 1970

97 NOV 12 PM 3: 11

For corners in

Lapeer (County)	Located In: Metamora Township	Corner Code #
1. Public Land Survey	T <u>6N</u> R <u>10E</u>	<u>M-3</u>
	T _____ R _____	_____
	T _____ R _____	_____
	T _____ R _____	_____
2. Property Controlling in Section	S _____ T _____ R _____	_____
	S _____ T _____ R _____	_____
3. Miscellaneous Property in Sec.	S _____ T _____ R _____	_____
	S _____ T _____ R _____	_____

Melissa DeVaugh
REGISTER OF DEEDS
LAPEER COUNTY MICHIGAN

Register of Deeds Stamp & File Number

4. Lot No. _____, Recorded Plat _____
5. Private Claims _____

I, Huston K. Kennedy, in a field survey on 8/15, 19 97 do hereby state that under requirements of P.A. 74, Michigan P.A. of 1970, the corner points mentioned in lines 1 and 2 above were in conformance with regulations and rules therefore as required in the current manual of survey instructions of the United States Department of the Interior, Bureau of Land Management or by a decree of a Court of Law and/or that the corner points mentioned in lines 3, 4 and 5 above were in conformance with the rules of the Michigan Board of Land Surveyors or by a Decree of a Court of Law, established, re-established, monumented, recovered, found as expressed below:

	A	B	C	D	E	F	G	H	I	J	K	L	M
1													
2	6		5		4		3		2		1		
3													
4	7		8		9		10		11		12		
5													
6	18		17		16		15		14		13		
7													
8	19		20		21		22		23		24		
9													
10	30		29		28		27		26		25		
11													
12	31		32		33		34		35		36		
13													

NOTE: Not more than 2 corners, all in the same town and range, may be recorded on this certificate.

- A. Description of original monument and accessories and/or subsequent restoration:
 1817-GLO Wanpler, D.S., Set Post 12" White Oak S46°W 82 Links
 1.) 1975-Henderson, PS #16043; LCRC L.3, pg.7 - Fnd 1/2" Iron Rod
 2.) 1975-Henderson, PS #16043; Survey L.3, pg.108 - Fnd 1/2" Iron Rod used same wit as 1975 LCRC
 3.) 1997-Kennedy, PS #17623; Unrecorded Survey - Fnd 1/2" Iron Rod


- B. Description of corner evidence found and/or method applied in restoring or reestablishing corner:
 1997 Kennedy Surveying, Inc. - Kennedy, PS #17623 - Fnd 1/2" Iron Rod .40 feet below the surface of the existing centerline of Thornville Road extending to the North & South, which has a gravel surface, and in the existing centerline of Hollow Corners Road extending to the East, which has a gravel surface. Also found second 1/2" Iron Rod 71.85 feet to the South in the existing centerline of of Thornville Road, also found a third 1/2" Iron Rod 67.39 feet North. This corner is being used and accepted as a common corner with Sections 6 & 7, T6N, R11E, Dryden Township (A-3).

Witnesses from were used to recover and verify the location of the found 1/2" Iron Rod.

I accepted the found 1/2" Iron Rod as the best evidence of the original corner position.

Field Measurements between see back side of LCRC

- C. Description of monument for corner and accessories established to perpetuate locating the position of the corner:
 M-3 I replaced the found 1/2" Iron Rod with a 1/2" x 24" Iron Rod w/2" diameter brass cap stamped Lapeer County Remonumentation M-3
 N60°W 49.00' Set PK & Remon Washer NE face 14" Oak
 S32°W 38.43' Set PK & Remon Washer SE face 10" Elm
 N36°E 52.56' Set PK & Remon Washer NW face 30" Oak
 S45°E 43.23' Set PK & Remon Washer SW face 52" Oak

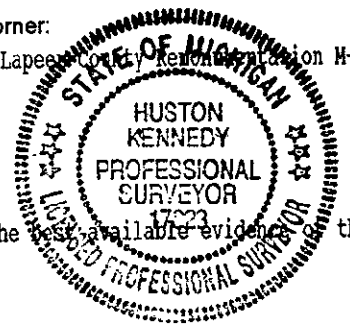

The selected location is accepted by me and is generally accepted by Professional Surveyors as the best available evidence of the position of the original corner.

Signed by [Signature]
Surveyor's Michigan License No. 17623

Date 9/29/97

ALSO 5 9.00
REPLI 0075
T.MONT 2.00

FIELD MEASUREMENTS BETWEEN

M-3 to A-3

No GLO
Common Corner

M-3 to M-2

GLO = 40 chains or 2640.00 Ft.
Unrecorded Survey by McAlpine, PS #1015 (May 1950) = 2661.48 Ft.
Unrecorded Survey by Kennedy, PS #17623 (8/97) = 2661.62 Ft.
GROUND-MEA = 2661.62 Ft.

M-3 to M-4

GLO = 40 chains or 2640 Ft.
Unrecorded Survey by McAlpine, PS #1015 (May 1950) = 2716.55 Ft.
GROUND-MEA = 2715.79 Ft.

PEER GROUP
APPROVED LAND CORNER
24 OCT 1997
PEER COUNTY,
RAY DAVIS P.S. CO. SURVEYOR
DATE 9-29-97