

MAY 15 2000

LAND CORNER RECORDATION CERTIFICATE  
Filing Requirement of Act 74, Mich. P.A. 1970

SECTION

For corners in  
Lapeer  
(County)

Located In: Metamora  
Twp.

Corner Code #

1. Public Land Survey	T	<u>6</u> N	R	<u>10</u> E	<u>M-6</u>
	T		R		
	T		R		
	T		R		
2. Property Controlling in Section	S		T	R	
	S		T	R	
3. Miscellaneous Property in Section	S		T	R	
	S		T	R	

RECEIVED FOR RECORD

95 AUG 15 PM 12: 33

LIBER NO. 005 PAGE NO. 263  
*Hester Debaugh*  
REGISTER OF DEEDS  
LAPPEER COUNTY, MICHIGAN

Register of Deeds Stamp & File Number

4. Lot No. \_\_\_\_\_, Recorded Plat \_\_\_\_\_  
5. Private Claims \_\_\_\_\_

A	B	C	D	E	F	G	H	I	J	K	L	M
2	6	5	4	3	2	1						
3												
4	7	8	9	10	11	12						
5												
6	18	17	16	15	14	13						
7												
8	19	20	21	22	23	24						
9												
10	30	29	28	27	26	25						
11												
12	31	32	33	34	35	36						
13												

I, Huston K. Kennedy, in a field survey on June 15, 19 94, do hereby certify that under requirements of P.A. 74, Michigan P.A. of 1970, the corner points mentioned in lines 1 and 2 above were in conformance with regulations and rules therefore as required in the current manual of survey instructions of the United States Department of the Interior, Bureau of Land Management or by a decree of a Court of Law and/or that the corner points mentioned in lines 3, 4 and 5 above were in conformance with the rules of the Michigan Board of Professional Surveyors or by a Decree of a Court of Law; established, re-established, monumented, re-monumented, recovered, found as expressed below:

NOTE: Not more than 4 corners, all in the same town and range, may be recorded on this certificate.

A. Description of original monument and accessories and/or subsequent restoration:

1822-GLO Wampler, D.S.; Set Post; 14" White Oak S63\*W 38 Links; 23" White Oak S85\*E 50 Links  
1.) 1979-Henderson, P.S. #16043; Survey L.005, Pg.314 - Fnd 1/2" Iron  
2.) 1981-Kennedy, P.S. #17623; Unrecorded Survey - Fnd 1/2" Iron Rod

PEER GROUP  
APPROVED LAND CORNER  
PA 345 OF 1990  
LAPPEER COUNTY

*Ray Davis*  
RAY DAVIS P.S. CO. SURVEYOR  
DATE 8-3-95

B. Description of corner evidence found and/or method applied in restoring or reestablishing corner:

1994 Kennedy Surveying, Inc. - Kennedy, P.S. #17623 - Fnd 1/2" Iron Rod 4' East of the centerline of Thornville Road, which has a gravel surface, fence and tree row extending to the East, and a pond to the West. I made a survey of the East 1/2 of Section 13, T6N, R10E, an accepted the West 1/4 corner of Section 18, T6N, R11E, as a common corner with the East 1/4 corner of Section 13, T6N, R10E.

Witnesses from Survey #1 were used to recover and verify the location of the found 1/2" Iron Rod.


I accepted the found 1/2" Iron Rod as the best evidence of the original corner position.

This LCRC is being Re-recorded to correct a typographically error R11E to R10E.

C. Description of monument for corner and accessories established to perpetuate locating the position of the corner:

M-6 & A-6  
S43°W 49.59' Set PK & Remon. Washer SE face 11" Cherry  
N15°E 50.17' Set PK & Remon. Washer West face 10" Bean Hoop  
N61°W 41.17' Set PK & Remon. Washer NE face 12" Oak  
N81°W 35.29' Set PK & Remon. Washer North face 15" Oak

The selected location is accepted by me and is generally accepted by Professional Surveyors as the best available evidence of the position of the original corner.

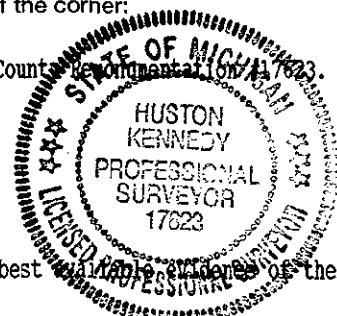

Signed by *Huston Kennedy* Date October 14, 1994  
Surveyor's Michigan License No. 17623

FORM APPROVED BY MICHIGAN STATE BOARD OF PROFESSIONAL SURVEYORS, JAN. 28, 1971  
REVISED MAY 14, 1975  
REVISED JAN. 1983