

1993

COMMISSION

REMONUMENTATION
LAND CORNER RECORDATION CERTIFICATE
Filing Requirement of Act 74, Mich. P.A. 1970

For corners in

<u>LAPEER</u> (County)	Located In:	Corner Code #
1. Public Land Survey	T <u>6</u> N R <u>10</u> E	<u>M-10</u>
	T _____ R _____	_____
	T _____ R _____	_____
	T _____ R _____	_____
2. Property Controlling in Section	S _____ T _____ R _____	_____
	S _____ T _____ R _____	_____
3. Miscellaneous Property in Sec.	S _____ T _____ R _____	_____
	S _____ T _____ R _____	_____
4. Lot No. _____, Recorded Plat _____		
5. Private Claims _____		

RECEIVED FOR RECORD
93 DEC 30 AM 10:17
LIBER NO. 5 PAGE NO. 49
Melissa Miles
REGISTERED LAND SURVEYOR
LAPEER COUNTY MICHIGAN

Register of Deeds Stamp & File Number

	A	B	C	D	E	F	G	H	I	J	K	L	M
2	6	5	4	3	2	1							
3													
4	7	8	9	10	11	12							
5													
6	18	17	16	15	14	13							
7													
8	19	20	21	22	23	24							
9													
10	30	29	28	27	26	25							
11													
12	31	32	33	34	35	36							
13													

I, Huston K. Kennedy, in a field survey on December, 19 93, do hereby certify that under requirements of P.A. 74, Michigan P.A. of 1970, the corner points mentioned in lines 1 and 2 above were in conformance with regulations and rules therefore as required in the current manual of survey instructions of the United States Department of the Interior, Bureau of Land Management or by a decree of a Court of Law and/or that the corner points mentioned in lines 3, 4 and 5 above were in conformance with the rules of the Michigan Board of Land Surveyors or by a Decree of a Court of Law; established, re-established, monumented, re-monumented, recovered, found as expressed below:

NOTE: Not more than 4 corners, all in the same town and range, may be recorded on this certificate.

A. Description of original monument and accessories and/or subsequent restoration:


GLO - Wampler, D.S.; Set 1/2 mile post; 22" White Oak N 59° E 6 lks; 18" ? S76° W 16 lks
1990 Bailey, P.S. #33968; Survey L.9, Pg.58; Fnd 1/2" iron rod

B. Description of corner evidence found and/or method applied in restoring or reestablishing corner:

1993 Kennedy Surveying, Inc. - Kennedy, P.S. #17623 - Fnd 1/2" iron rod in the center of Rock Valley Road to the East and on the West edge of Rock Valley Road to the South, which is gravel.
Found all 4 witness points existing. They were used to recover the found 1/2" iron rod.
I accepted the found 1/2" iron rod as the best evidence of the original corner position.

C. Description of monument for corner and accessories established to perpetuate locating the position of the corner:

M-10 1/2" x 24" iron rod w/ 3" diameter brass cap
N73°W 8.73' Set nail w/remon. tag above existing witness in N. face Twin 12" Maple
N26°E 37.30' Set nail w/remon. tag above existing witness in SE face 16" Oak
S63°E 35.59' Set nail w/remon. tag above existing witness in N. face 7" Cherry
S14°W 78.55' Set nail w/remon. tag in E. face 21" Ash
N18°W 50.91' Set nail w/remon. tag in SW face 16" Maple

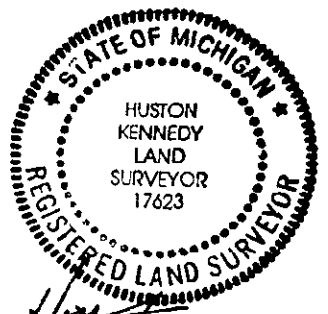

Signed by *Huston K. Kennedy* Date 4/24/93
Surveyor's Michigan License No. 17623