

1993

COMMISSION

REMONUMENTATION
LAND CORNER RECORDATION CERTIFICATE
Filing Requirement of Act 74, Mich. P.A. 1970

RECEIVED FOR RECORD

For corners in

LAPEER
(County)

Located In:

Corner Code #

- 1. Public Land Survey T 6 N R 10 E M-12
 T _____ R _____
 T _____ R _____
 T _____ R _____
- 2. Property Controlling S _____ T _____ R _____
 in Section S _____ T _____ R _____
- 3. Miscellaneous S _____ T _____ R _____
 Property in Sec. S _____ T _____ R _____
- 4. Lot No. _____, Recorded Plat _____
- 5. Private Claims _____

93 DEC 30 PM 10:19
LIBER NO. 5 FILE NO. 51
Melissa Miles
REGISTERED LAND SURVEYOR
LAPEER MICHIGAN

Register of Deeds Stamp & File Number

A	B	C	D	E	F	G	H	I	J	K	L	M
2	6	5	4	3	2	1						
3												
4	7	8	9	10	11	12						
5												
6	18	17	16	15	14	13						
7												
8	19	20	21	22	23	24						
9												
10	30	29	28	27	26	25						
11												
12	31	32	33	34	35	36						
13												

I, Huston K. Kennedy, in a field survey on December, 19 93, do hereby certify that under requirements of P.A. 74, Michigan P.A. of 1970, the corner points mentioned in lines 1 and 2 above were in conformance with regulations and rules therefore as required in the current manual of survey instructions of the United States Department of the Interior, Bureau of Land Management or by a decree of a Court of Law and/or that the corner points mentioned in lines 3, 4 and 5 above were in conformance with the rules of the Michigan Board of Land Surveyors or by a Decree of a Court of Law; established, re-established, monumented, re-monumented, recovered, found as expressed below:

NOTE: Not more than 4 corners, all in the same town and range, may be recorded on this certificate.

A. Description of original monument and accessories and/or subsequent restoration:

GLO - Wampler, D.S.; Set 1/2 mile post; 16" Aspen S 21°E 95 lks, 7" White Oak N 40°W 1.83 lks
1981 Elrich, P.S. #18986; LCRC L.3, Pg.610; Fnd 1/2" iron pipe
1981 Elrich, P.S. #18986; Survey L.5, Pg.948; Fnd 1/2" iron pipe; Same wits as 1981 LCRC


B. Description of corner evidence found and/or method applied in restoring or reestablishing corner:

1993 Kennedy Surveying, Inc. - Kennedy, P.S. #17623 - Fnd 1/2" iron pipe in the center of Hempstead Road to the South and of the center of Jonathan Road to the East. Both are gravel roads.
Found 2 previous witnesses existing and used them to recover the found 1/2" iron pipe. The iron pipe is located West of the travelled road because the road curves at the intersection of Hempstead Road and Jonathan Road.

I accepted the found iron pipe as the best evidence of the original corner position.

C. Description of monument for corner and accessories established to perpetuate locating the position of the corner:

M-12 1/2" x 24" iron rod w/ 3" diameter brass cap
N22°E 55.09' Set nail w/remon. tag in W. face Power Pole
S15°W 44.86' Set nail w/remon. tag in E. face Twin 16" Oak
Due West 26.45' Set nail w/remon. tag above existing witness in S. face 23" Oak
S81°E 134.49' Set nail w/remon. tag in N. face 25" Oak
S15°W 29.31' Set nail w/remon. tag in E. face 13" Oak

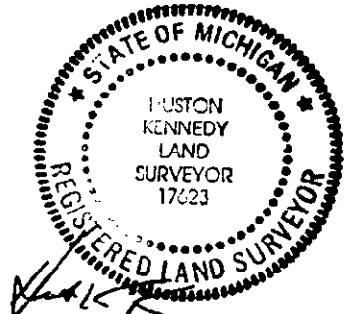

Signed by [Signature] Date 12/24/93

Surveyor's Michigan License No. 17623