

SURVEY & REMONUMENTATION

MAY 28 1997

COMMISSION

REMONUMENTATION

LAND CORNER RECORDATION CERTIFICATE
Filing Requirement of Act 74, Mich. P.A. 1970

RECEIVED FOR RECORD

97 JAN 13 PM 2:45

For corners in

<u>LAPEER</u> County	Located In:	Corner Code #
1. Public Land Survey	T <u>6N</u> R <u>11E</u>	<u>A-1</u>
	T _____ R _____	_____
DRYDEN TOWNSHIP	T _____ R _____	_____
	T _____ R _____	_____
2. Property Controlling in Section	S _____ T _____ R _____	_____
	S _____ T _____ R _____	_____
3. Miscellaneous Property in Sec.	S _____ T _____ R _____	_____
	S _____ T _____ R _____	_____

Melissa DeVaugh
 REGISTER OF DEEDS
 LAPEER COUNTY, MICHIGAN

Register of Deeds Stamp & File Number

4. Lot No. _____, Recorded Plat _____
 5. Private Claims _____

	A	B	C	D	E	F	G	H	I	J	K	L	M
2	6	5	4	3	2	1							
3													
4	7	8	9	10	11	12							
5													
6	18	17	16	15	14	13							
7													
8	19	20	21	22	23	24							
9													
10	30	29	28	27	26	25							
11													
12	31	32	33	34	35	36							
13													

I, HAROLD N. ELRICH, in a field survey on APRIL 11, 19 96, do hereby certify that under requirements of P.A. 74, Michigan P.A. of 1970, the corner points mentioned in lines 1 and 2 above were in conformance with regulations and rules therefore as required in the current manual of survey instructions of the United States Department of the Interior, Bureau of Land Management or by a decree of a Court of Law and/or that the corner points mentioned in lines 3, 4 and 5 above were in conformance with the rules of the Michigan Board of Land Surveyors or by a Decree of a Court of Law, established, re-established, monumented, re-monumented, recovered, found as expressed below:

NOTE: Not more than 4 corners, all in the same town and range, may be recorded on this certificate.

A. Description of original monument and accessories and/or subsequent restoration:

- 1868 GILBERT BATES - STONE 19.14.10 B. OAK 4 S 40° W 39 LINKS, B. OAK 12 S 83° W 129 LINKS, APPLE 4 N 47° E 88 LINKS
- 1977 HAROLD N. ELRICH P.S. #18986, LIBER 004, PAGE 221, FOUND 1/2" IRON N 10° E 37.90 FEET TELEPHONE POLE, S 60° W 43.32 FEET 20" OAK S 30° E 61.32 FEET 36" MAPLE, N 30° W 33.00 FEET 12" OAK

B. Description of corner evidence found and/or method applied in restoring or reestablishing corner:

1996 HAROLD N. ELRICH P.S. #18986 FOUND 1/2" IRON STRAIGHT ON THE SOUTHERLY EDGE OF SUTTON ROAD AND WESTERLY EDGE OF THORNVILLE ROAD. FOUND FOUR WITNESSES FROM PREVIOUS SURVEY THAT LOCATE 1/2" IRON FOUND. COMMON WITH M-1, T6N-R10E
 ACCEPTED 1/2" IRON FOUND AS BEST LOCATION OF ORIGINAL POSITION ON NORTHWEST CORNER OF SECTION 6, T6N-R11E, DRYDEN TOWNSHIP, LAPEER COUNTY, MICHIGAN


MEASURED REFERENCES - A-1 TO B-1 2637.14 FEET
 A-1 TO A-2 2836.59 FEET
 A-1 TO L-1 2737.62 FEET (NORTH 1/4 CORNER OF SECTION 1, T6N-R10E METAMORA TOWNSHIP)

C. Description of monument for corner and accessories established to perpetuate locating the position of the corner:

A-1 PLACED LAPEER COUNTY REMONUMENTATION CAP ON 1/2" IRON FOUND
 SET NEW WITNESSES - N 40° E 36.06 FEET P.K. NAIL & WASHER IN 14" OAK
 S 45° E 61.22 FEET P.K. NAIL & WASHER IN 40" MAPLE
 S 50° W 43.33 FEET P.K. NAIL & WASHER IN 24" OAK
 N 30° W 32.90 FEET P.K. NAIL & WASHER IN 18" OAK

PEER GROUP
 APPROVED LAND CORNER
 PA 345 OF 1990
 LAPEER COUNTY

Ray Davis
 RAY DAVIS P.S. CO. SURVEYOR
 Date 12-30-96 9-10-96

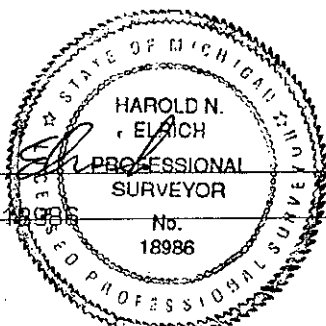

Signed by Harold N. Elrich
 Surveyor's Michigan License No. 18986