

MAR 13 1998

SECTION

REMONUMENTATION

LAND CORNER RECORDATION CERTIFICATE
Filing Requirement of Act 74, Mich. P.A. 1970

RECEIVED FOR RECORD
97 NOV 12 PM 2: 59

For corners in

Lapeer

(County)

Located in:

Dryden Township

Corner Code #

- 1. Public Land Survey T 6N R 11E A-3
- T R _____
- T R _____
- T R _____
- T R _____
- 2. Property Controlling S T R _____
- in Section S T R _____
- 3. Miscellaneous S T R _____
- Property in Sec. S T R _____

Melissa De Vaughn
REGISTER OF DEEDS
LAPEER COUNTY MICHIGAN

Register of Deeds Stamp & File Number

- 4. Lot No. _____, Recorded Plat _____
- 5. Private Claims _____

I, Huston K. Kennedy, in a field survey on 8/15, 19 97 do hereby state that under requirements of P.A. 74, Michigan P.A. of 1970, the corner points mentioned in lines 1 and 2 above were in conformance with regulations and rules therefore as required in the current manual of survey instructions of the United States Department of the Interior, Bureau of Land Management or by a decree of a Court of Law and/or that the corner points mentioned in lines 3, 4 and 5 above were in conformance with the rules of the Michigan Board of Land Surveyors or by a Decree of a Court of Law; established, re-established, monumented, recovered, found as expressed below:

NOTE: Not more than 2 corners, all in the same town and range, may be recorded on this certificate.

	A	B	C	D	E	F	G	H	I	J	K	L	M
1													
2	6		5		4		3		2		1		
3													
4	7		8		9		10		11		12		
5													
6	18		17		16		15		14		13		
7													
8	19		20		21		22		23		24		
9													
10	30		29		28		27		26		25		
11													
12	31		32		33		34		35		36		
13													

A. Description of original monument and accessories and/or subsequent restoration:

- 1817-GLO Wampler, D.S., Set Post
- 1.) 1976-Kobs, PS #14097; LCRC L.3, pg.259 - Fnd 1/2" Iron Bar
- 2.) 1976-Kobs, PS #14097; Survey L.3, pg.841 - Fnd 1/2" Iron Bar, used same wit as 1976 LCRC
- 3.) 1987-Elrich, PS #18986; Survey L.7, pg.520 - Fnd a Iron Rod
- 4.) 1988-Elrich, PS #18986; Survey L.7, pg.791- Fnd a Iron Rod, used same wit as 1987 Survey
- 5.) 1988-Elrich, PS #18986; Survey L.8, pag. 41 - Fnd a Iron Rod used same wit as 1987 Survey
- 6.) 1996-Elrich, PS #18986; Survey L.11, pg.562 - Fnd Iron Rod

B. Description of corner evidence found and/or method applied in restoring or reestablishing corner:

1997 Kennedy Surveying, Inc. - Kennedy, PS #17623 - Fnd 1/2" Iron Rod .40 feet below the surface and in the existing centerline of Thornville Road extending to the North & South, which has a gravel surface, and in the existing centerline of Hollow Corners Road extending to the East, which has a gravel surface. Found second 1/2" Iron Rod 71.85 feet to the South in the existing centerline of Thornville Road, also found third 1/2" Iron Rod 67.39 feet North. This corner is being used and accepted as a common corner with Sections 1 & 12, T6N, R10E, Metamora Township (H-3).

Witnesses from LCRC #1, Survey #3 and #6 were used to recover and verify the location of the found 1/2" Iron Rod.

I accepted the found 1/2" Iron Rod as the best evidence of the original corner position.

Field Measurements between see back side of LCRC

C. Description of monument for corner and accessories established to perpetuate locating the position of the corner:

- A-3 I replaced the found 1/2" Iron Rod with a 1/2" x 24" Iron Rod w/2" diameter brass cap stamped Lapeer County Remonumentation A-3
- N60°W 49.00' Set PK & Remon Washer NE face 14" Oak
- S32°W 38.43' Set PK & Remon Washer SE face 10" Elm
- N36°E 52.56' Set PK & Remon Washer NW face 30" Oak
- S45°E 43.23' Set PK & Remon Washer SW face 52" Oak

The selected location is accepted by me and is generally accepted by Professional Surveyors as the best available evidence of the position of the original corner.



Signed by _____

Date 10-3-97

Surveyor's Michigan License No. 17623

LIBER 0005 PAGE 0458

FIELD MEASUREMENTS BETWEEN

A-3 to A-2

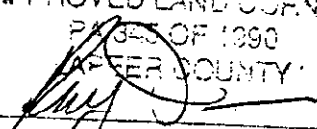
No GLO
Survey recorded in Liber 003, page 841 = 2661.50 Ft.
Survey recorded in Liber 008, page 41 = 2661.50 Ft.
GROUND-MEA = 2661.62 Ft.

A-3 to A-4

No GLO
Survey recorded in Liber 007, page 520 = 2561.69 Ft.
Survey recorded in Liber 11, page 562 = 2561.69 Ft.
GROUND-MEA = 2561.62 Ft.

A-3 to M-3

GLO
Common Corner

PEER GROUP
APPROVED LAND CORNER

RAYDA W. S. CO. SURVEYOR
DATE 9-29-97

700 4-10
E L 1175
MEASUREMENT 1110