

SURVEY &
REMONUMENTATION

MAR 13 1998

REMONUMENTATION


SECTION

LAND CORNER RECORDATION CERTIFICATE
Filing Requirement of Act 74, Mich. P.A. 1970

RECEIVED FOR RECORD
97 NOV 12 PM 3: 01

For corners in

Lapeer <small>(County)</small>	Located In: Dryden Township	Corner Code #	
1. Public Land Survey	T 6N R 11E	A-10	_____
	T _____	_____	_____
	T _____	_____	_____
	T _____	_____	_____
2. Property Controlling in Section	S _____	T _____	R _____
	S _____	T _____	R _____
3. Miscellaneous Property in Sec.	S _____	T _____	R _____
	S _____	T _____	R _____

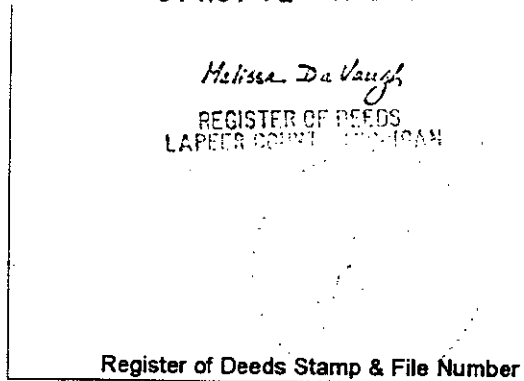

4. Lot No. _____, Recorded Plat _____
5. Private Claims _____

I, Huston K. Kennedy, in a field survey on 8/15, 19 97 do hereby state that under requirements of P.A. 74, Michigan P.A. of 1970, the corner points mentioned in lines 1 and 2 above were in conformance with regulations and rules therefore as required in the current manual of survey instructions of the United States Department of the Interior, Bureau of Land Management or by a decree of a Court of Law and /or that the corner points mentioned in lines 3, 4 and 5 above were in conformance with the rules of the Michigan Board of Land Surveyors or by a Decree of a Court of Law, established, re-established, monumented, recovered, found as expressed below:

NOTE: Not more than 2 corners, all in the same town and range, may be recorded on this certificate.

	A	B	C	D	E	F	G	H	I	J	K	L	M
1													
2	6			5			4			3			2
3													
4	7			8			9			10			11
5													
6	18			17			16			15			14
7													
8	19			20			21			22			23
9													
10	30			29			28			27			26
11													
12	31			32			33			34			35
13													

A. Description of original monument and accessories and/or subsequent restoration:

- 1817-GLO Wampler, D.S., No post was set
- 1.) 1980-Elrich, PS #18986; LCRC L.3, pg.573 - Fnd 1/2" Iron
- 2.) 1992-Kennedy, PS #17623; LCRC L.4, pg.410 - Fnd 1/2" Iron Rod
- 3.) 1993-Kennedy, PS #17623; LCRC L.5, pg.49 - Fnd 1/2" Iron Rod
- 4.) 1990-Bailey, PS #33968; Survey L.9, pg.58 - Fnd 1-1/4" Pipe
- 5.) 1978-State Land Surveying Company; Unrecorded Survey - Fnd 1/2" Iron
- 6.) 1989-Carlson, PS #9189; Unrecorded Survey - Fnd a 1/2" Re-rod
- 7.) 1990-Kennedy, PS #17623; Unrecorded Survey - Fnd 1/2" Iron Rod, used same wit as 1992 LCRC

B. Description of corner evidence found and/or method applied in restoring or reestablishing corner:

1997 Kennedy Surveying, Inc. - Kennedy, PS #17623 - Fnd 1/2" Iron Rod w/2" diameter brass cap stamped Lapeer County Remonumentation M-10 in the existing centerline of Rock Valley Road extending to the East, which has a gravel surface, and on the West edge of Rock Valley Road extending to the South, with a tree, rock and fence row extending to the West. This corner is being accepted and used as a common corner with the East 1/4 corner of Section 25, T6N, R10E, Metamora Township (M-10).

Witnesses from LCRC #1, 2, Surveys #4, 5 and 6 were used to recover and verify the location of the found 1/2" Iron Rod w/2" diameter brass cap stamped Lapeer County Remonumentation M-10.

I accepted the found 1/2" Iron Rod w/2" diameter brass cap stamped Lapeer County Remonumentation M-10 as the best evidence of the original corner position.

Field Measurements between see back side of LCRC

C. Description of monument for corner and accessories established to perpetuate locating the position of the corner:

- A-10 I accepted the found 1/2" Iron Rod w/2" diameter brass cap stamped Lapeer County Remonumentation M-10
- N73°W 7.83' Fnd Nail & Remon Washer North face twin 12" Maple
- N26°E 37.30' Fnd Nail & Remon Washer SE face 16" Oak
- S63°E 35.59' Fnd Nail & Remon Washer North face 7" Cherry
- S14°W 78.55' Fnd Nail & Remon Washer East face 21" Ash
- N18°W 50.91' Fnd Nail & Remon Washer SW face 16" Maple

The selected location is accepted by me and is generally accepted by Professional Surveyors as the best available evidence of the position of the original corner.

Signed by _____
Surveyor's Michigan License No. 17623

Date 9-30-97



LIBER 0005 PAGE 0462

PEEP GROUP
APPROVED LAND CORNER
PAGE 04 OF 1390
L. PEEB COUNTY

RAY DAVIS, S. C. SURVEYOR
DATE 9-29-97

FIELD MEASUREMENTS BETWEEN

A-10 to A-11

No GLO
Unrecorded Survey by Carlson, PS #9189 (4/89) = 2548.12 Ft.
GROUND-MEA = (8/97) = 2548.59 Ft.

A-10 to M-10

No GLO
Common Corner

RECORD CC
REMI 1075
REMI 200