MAR 2 9 1999

SECTION

REMONUMENTATION

LAND CORNER RECORDATION CERTIFICATE
Filing Requirement of Act 74, Mich. P.A. 1970

RECEIVED FOR RECORD
99 JAN -6 PM 1:21
Melissa DeVaugh
REGISTER OF DEEDS
LAPEER COUNTY, MICHIGAN

(436)
Register of Deeds Stamp & File Number

For corners in

LAPEER (County)

Located In: DRYDEN TOWNSHIP

Corner Code #

1. Public Land Survey T 6N R 11E M-2
   T___ R___
   T___ R___
   T___ R___
2. Property Controlling in Section S___ T___ R___
   S___ T___ R___
3. Miscellaneous Property in Sec. S___ T___ R___
   S___ T___ R___

4. Lot No. _____, Recorded Plat _____
5. Private Claims _____

I, Shelby W. Money, in a field survey on October 8, 19 98 do hereby certify that under requirements of P.A. 74, Michigan P.A. of 1970, the corner points mentioned in lines 1 and 2 above were in conformance with regulations and rules therefore as required in the current manual of survey instructions of the United States Department of the Interior, Bureau of Land Management or by a decree of a Court of Law and /or that the corner points mentioned in lines 3, 4 and 5 above were in conformance with the rules of the Michigan Board of Land Surveyors or by a Decree of a Court of Law: established, re-established, monumented, re-monumented, recovered, found as expressed below:

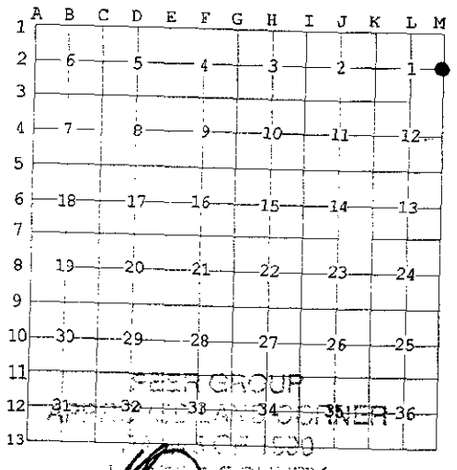

RAY OF THE PVT. CO. SURVEYOR
DATE 10-26-98

NOTE: Not more that 4 corners, all in the same town and range, may be recorded on this certificate.

A. Description of original monument and accessories and/or subsequent restoration:

Township boundary for T6N, R11E, Dryden Twp. was surveyed in 1816 by Wampler. Set ½ Mile Post at 40 chains north of post set for southeast corner of section 1.

1. L1, Pg 399 March 1972, survey by Henderson, Bates, Elrich & Schuler, Inc.
2. L3, Pg 286 June 1975, survey by Kay Engineering.
3. L3, Pg 351 July 1975, survey by Kay Engineering

The above surveys do not identify a position for, or evidence of a found corner. The only evidence of an East-West Quarter line is found in item 1.

B. Description of corner evidence found and/or method applied in restoring or reestablishing corner:

Bishop Road runs north and south and has a gravel surface. There is no visible evidence of occupation to the west at the road. From the center post the fence line was located to 1338.61 ft to the east at which point we located an iron with cap #18986 in a north south fence line. The east-west fence was marked with remains of wire located on the ground, suspended in trees or remains of posts. M-2 was placed on line between M-1 and M-3 at the extension of a line from the center post to the iron found 1338.61 ft to the east.

C. Description of monument for corner and accessories established to perpetuate locating the position of the corner:

M-2 Set a ½" iron with a 2" diameter brass cap stamped LAPEER COUNTY REMONUMENTATION, PS#30092.

1. Az 20° 82.05' to a P.K. nail with Lapeer County Remon Tag found in west face of a 45" oak.
2. Az 175° 79.40' to P. K. nail & Lapeer County Remon Tag found in west face of an 38" oak.
3. Az 185° 41.29' to iron with Lapeer County Remon Cap, A-2 of T. 6 N., R. 12 E., Almont Township.
4. Az 225° 51.19' to small notch in west end of 66" CMP (South Culvert)
5. Az 350° 71.06' to nail & Lapeer County Remon Tag set in southwest face of a 30" oak.

FIELD MEASUREMENTS M-2 TO M-1 2908.78 M-2 TO M-3 2597.53
M-2 TO A-2 ALMONT 41.29

THE SELECTED LOCATION IS ACCEPTED BY ME AND IS GENERALLY ACCEPTED BY PROFESSIONAL SURVEYORS AS THE BEST AVAILABLE EVIDENCE OF THE POSITION OF THE ORIGINAL CORNER.

Signed by _____ Date 12/30/98

Surveyor's Michigan License No. 30092

STATE OF MICHIGAN
SHELBY W. MONEY
PROFESSIONAL SURVEYOR
NO. 30092
LICENSED PROFESSIONAL SURVEYOR

FORM APPROVED BY MICHIGAN STATE BOARD OF LAND SURVEYORS, JAN. 28, 1971
REVISED MAY 14, 1975
REVISED JAN., 1983
REVISED OCT., 1996

LIBER 0006 PAGE 0115