

SURVEY &
REMONUMENTATION

1993

COMMISSION

REMONUMENTATION
LAND CORNER RECORDATION CERTIFICATE
Filing Requirement of Act 74, Mich. P.A. 1970

RECEIVED FOR RECORD

93 DEC 22 PM 2:42

LIBER 5 PAGE 7
Shelby W. Money
REMONUMENTATION
LAPEER COUNTY SURVEYOR

For corners in

LAPEER
(County)

Located In: Dryden Township Corner Code #

- | | | |
|---------------------------------------|--------------------------|-------------|
| 1. Public Land Survey | T <u>6N</u> R <u>11E</u> | <u>M-13</u> |
| | T _____ R _____ | _____ |
| | T _____ R _____ | _____ |
| | T _____ R _____ | _____ |
| 2. Property Controlling in Section | S _____ T _____ R _____ | _____ |
| | S _____ T _____ R _____ | _____ |
| 3. Miscellaneous Property in Sec. | S _____ T _____ R _____ | _____ |
| | S _____ T _____ R _____ | _____ |
| 4. Lot No. _____, Recorded Plat _____ | | |
| 5. Private Claims _____ | | |

Register of Deeds Stamp & File Number

	A	B	C	D	E	F	G	H	I	J	K	L	M
2	6		5		4		3		2		1		
3													
4	7		8		9		10		11		12		
5													
6	18		17		16		15		14		13		
7													
8	19		20		21		22		23		24		
9													
10	30		29		28		27		26		25		
11													
12	31		32		33		34		35		36		
13													

I, Shelby W. Money, in a field survey on September 13, 19 93, do hereby certify that under requirements of P.A. 74, Michigan P.A. of 1970, the corner points mentioned in lines 1 and 2 above were in conformance with regulations and rules therefore as required in the current manual of survey instructions of the United States Department of the Interior, Bureau of Land Management or by a decree of a Court of Law and/or that the corner points mentioned in lines 3, 4 and 5 above were in conformance with the rules of the Michigan Board of Land Surveyors or by a Decree of a Court of Law; established, re-established, monumented, re-monumented, recovered, found as expressed below:

NOTE: Not more than 4 corners, all in the same town and range, may be recorded on this certificate.

A. Description of original monument and accessories and/or subsequent restoration:

POST G.L.O. NOTES / PAGES 345 AND 347

LCRC (1974) L.2 P.667 BY H. KOBS #14097


PER G.L.O. NOTES: CORNER IN COMMON TO T.5 & 6N., R.11 & 12E.

B. Description of corner evidence found and/or method applied in restoring or reestablishing corner:

FOUND 1/2" SMOOTH IRON USING L.C.R.C. LIBER 2 PAGE 67
 FOUND PK IN UTILITY POLE SOUTH 53.92'
 FOUND PK IN ANCHOR POST NORTHWEST 52.54'
 FOUND ANCHOR POST NORTHEAST 40.6'

C. Description of monument for corner and accessories established to perpetuate locating the position of the corner:

SET LAPEER COUNTY REMONUMENTATION MARKER #30092 / M-13 OVER 1/2" SMOOTH IRON CORNER IN CENTERLINE OF BOARDMAN ROAD EAST AND WEST
 9'± WEST TO CENTERLINE OF BISHOP ROAD NORTH
 SOUTH 53.84' SET LAPEER TAG/NAIL IN THE EAST FACE OF UTILITY POLE
 N 70° W 137.81' SET LAPEER TAG/NAIL IN THE SOUTH ROOT OF 36" MAPLE TREE
 N 25° W 84.11' SET LAPEER TAG/NAIL IN THE EAST FACE OF 30" MAPLE TREE
 N 30° E 67.36' SET LAPEER TAG/NAIL IN THE WEST FACE OF UTILITY POLE
 S 30° E 46.02' SET LAPEER TAG/NAIL IN THE SOUTHWEST FACE OF 15" WILD CHERRY TREE
 S 25° W 154.70' TO NORTHEAST CORNER OF HOUSE #5990

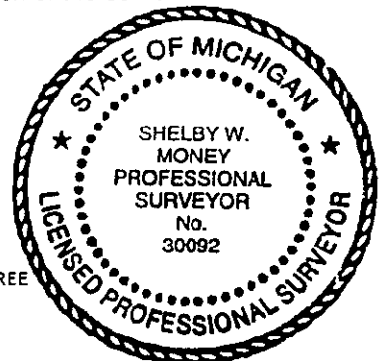

Signed by Shelby W. Money Date December 21, 1993
 Surveyor's Michigan License No. 30092