

SURVEY & REMONUMENTATION

MAR 13 1998

SECTION

LAND CORNER RECORDATION CERTIFICATE
Filing Requirement of Act 74, Mich. P.A. 1970
 Almont TOWNSHIP

RECEIVED FOR RECORD

98 JAN -7 PH 2: 52

For corners in

<u>LAPEER</u>	Located In:	Corner Code #
(County)		
1. Public Land Survey	<u>T 6 N R 12 E</u>	<u>A-1</u>
	T ___ R ___	_____
	T ___ R ___	_____
	T ___ R ___	_____
2. Property Controlling in Section	S ___ T ___ R ___	_____
	S ___ T ___ R ___	_____
3. Miscellaneous Property in Sec.	S ___ T ___ R ___	_____
	S ___ T ___ R ___	_____

Melissa De Vaughn
 REGISTER OF DEEDS
 LAPEER COUNTY, MICHIGAN

Register of Deeds Stamp & File Number

4. Lot No. _____, Recorded Plat _____
 5. Private Claims _____

I, WILLIAM E. SODERBERG, in a field survey on JUNE 12, 19 97 do hereby certify that under requirements of P.A. 74, Michigan P.A. of 1970, the corner points mentioned in lines 1 and 2 above were in conformance with regulations and rules therefore as required in the current manual of survey instructions of the United States Department of the Interior, Bureau of Land Management or by a decree of a Court of Law and for that the corner points mentioned in lines 3, 4 and 5 above were in conformance with the rules of the Michigan Board of Land Surveyors or by a Decree of a Court of Law; established, re-established, monumented, re-monumented, recovered, found as expressed below:

NOTE: Not more than 4 corners, all in the same town and range, may be recorded on this certificate.

A	B	C	D	E	F	G	H	I	J	K	L	M
1												
2	6		5		4		3		2		1	
3												
4	7		8		9		10		11		12	
5												
6	19		17		16		15		14		13	
7												
8	19		20		21		22		23		24	
9												
10	30		29		28		27		26		25	
11												
12	31		32		33		34		35		36	
13												

A. Description of original monument and accessories and/or subsequent restoration:

1. Glo 1816	Joseph Wampler	Set post, nor witnesses left
2. Survey 9/28/71	B. Henderson #16043	L.1, P.284 Unknown M-1 Dryden
3. Survey 1/27/72	B. Henderson #16043	L.1, P.339 Unknown M-1 Dryden
4. Survey 12/5/75	B. Kay #14096	L.3, P.490 Found 1/2" Rod A-1 Almont
5. Survey 7/18/77	B. Kay #14096	L.4, P.177 Found 1/2" Rod A-1 Almont
6. Survey 8/19/82	H. Elrich #18986	L.6, P.422 Found 1/2" Iron A-1 Almont
7. Survey 7/29/83	H. Elrich #18986	L.6, P.590 Found 1/2" Iron A-1 Almont
8. LCRC 9/28/84	H. Kobs #14097	L.4, P.82 Found 1/2" Rod A-1 Almont
9. Survey 1/8/86	H. Kobs #14097	L.7, P.217 Found 1/2" Rod A-1 Almont
10. Survey 1/8/86	H. Kobs #14097	L.7, P.953 Found 1/2" Rod A-1 Almont
11. Survey 8/31/89	H. Elrich #18986	L.8, P.428 Found 1/2" Iron A-1 Almont
12. Survey 3/14/95	D. King #30085	L.10, P.948 Found 1/2" Iron bar A-1 Almont

NEER GROUP
 APPROVED LAND CORNER
 TABLE OF 1990
 LAPEER COUNTY
William E. Soderberg
 WILLIAM E. SODERBERG, P.S. CO. SURVEYOR
 DATE 10-13-97

B. Description of corner evidence found and/or method applied in restoring or reestablishing corner.

Found a 1/2" rebar at the centerlines of Sutton Road (gravel) East and West and Bishop Road (gravel) to the South. This corner is common with M-1 Dryden Township T.6N.,R.11E. The found rebar is 1.83 feet South of the Township line of Attica Township T.7N.,R.11E.

Witness found: From items 6,7 and 12 SSW 135.44' PK in 18" Wild Cherry


Distances: A-1 to M-13 Attica Township 710.56 feet A-1 to K-13 Attica Township 1907.82 feet
 A-1 to A-2 Almont Township 2950.07 feet No GLO

C. Description of monument for corner and accessories established to perpetuate locating the position of the corner.

We placed a standard Lapeer County Remonumentation Brass cap on the found 1/2" rebar stamped #17635 as the best location for this corner as accepted by the Professional Surveyors in this area.

- S. 15° W. 135.33' Set PK/Lapeer County remon tag in East face 18" Wild Cherry below found PK
- S. 15° E. 91.78' Set PK/Lapeer County remon tag in West face 10" Pine
- S. 45° E. 83.90' Set PK/Lapeer County remon tag in Northeast face 10" Pine
- S. 75° E. 136.78' Set PK/Lapeer County remon tag in Northeast face 10" Pine

Signed by *William E. Soderberg* Date November 18, 1997
 Surveyor's Michigan License No. 17635

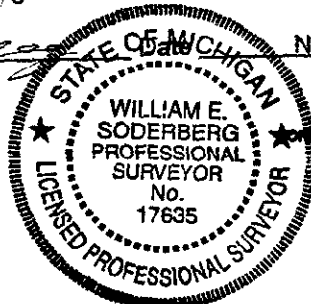

APPROVED BY MICHIGAN STATE BOARD OF LAND SURVEYORS, JAN. 28, 1971
 REVISED MAY 14, 1975
 REVISED JAN., 1983