

**SURVEY &  
REMONUMENTATION**

MAY 28 1997

COMMISSION

**LAND CORNER RECORDATION CERTIFICATE  
Filing Requirement of Act 74, Mich. P.A. 1970**

RECEIVED FOR RECORD

96 DEC 27 PH 1:01

For corners in

|                                       |                                |                      |
|---------------------------------------|--------------------------------|----------------------|
| <u>Lapeer</u><br>(County)             | Located In:<br>Almont Township | Corner Code #<br>A-3 |
| 1. Public Land Survey                 | T <u>6N</u> R <u>12E</u>       | <u>A-3</u>           |
|                                       | T ___ R ___                    | _____                |
|                                       | T ___ R ___                    | _____                |
|                                       | T ___ R ___                    | _____                |
| 2. Property Controlling<br>in Section | S ___ T ___ R ___              | _____                |
|                                       | S ___ T ___ R ___              | _____                |
| 3. Miscellaneous<br>Property in Sec.  | S ___ T ___ R ___              | _____                |
|                                       | S ___ T ___ R ___              | _____                |

*Melissa De Vaughn*  
REGISTER OF DEEDS  
LAPEER COUNTY MICHIGAN

Register of Deeds Stamp & File Number

4. Lot No. \_\_\_\_\_, Recorded Plat \_\_\_\_\_  
5. Private Claims \_\_\_\_\_

I, William E. Soderberg, in a field survey on May 7, 19 96 do hereby certify that under requirements of P.A. 74, Michigan P.A. of 1970, the corner points mentioned in lines 1 and 2 above were in conformance with regulations and rules therefore as required in the current manual of survey instructions of the United States Department of the Interior, Bureau of Land Management or by a decree of a Court of Law and/or that the corner points mentioned in lines 3, 4 and 5 above were in conformance with the rules of the Michigan Board of Land Surveyors or by a Decree of a Court of Law, established, re-established, monumented, re-monumented, recovered, found as expressed below.

**NOTE: Not more than 4 corners, all in the same town and range, may be recorded on this certificate.**

| A  | B  | C | D  | E | F  | G | H  | I | J  | K | L  | M |
|----|----|---|----|---|----|---|----|---|----|---|----|---|
| 1  |    |   |    |   |    |   |    |   |    |   |    |   |
| 2  | 6  |   | 5  |   | 4  |   | 3  |   | 2  |   | 1  |   |
| 3  |    |   |    |   |    |   |    |   |    |   |    |   |
| 4  | 7  |   | 8  |   | 9  |   | 10 |   | 11 |   | 12 |   |
| 5  |    |   |    |   |    |   |    |   |    |   |    |   |
| 6  | 18 |   | 17 |   | 16 |   | 15 |   | 14 |   | 13 |   |
| 7  |    |   |    |   |    |   |    |   |    |   |    |   |
| 8  | 19 |   | 20 |   | 21 |   | 22 |   | 23 |   | 24 |   |
| 9  |    |   |    |   |    |   |    |   |    |   |    |   |
| 10 | 30 |   | 29 |   | 28 |   | 27 |   | 26 |   | 25 |   |
| 11 |    |   |    |   |    |   |    |   |    |   |    |   |
| 12 | 31 |   | 32 |   | 33 |   | 34 |   | 35 |   | 36 |   |
| 13 |    |   |    |   |    |   |    |   |    |   |    |   |

A. Description of original monument and accessories and/or subsequent restoration:

- 1818 Joseph Wampler Set post No witnesses found
- 7-6-89 Survey recorded by Earl Gravlin 23510 in liber 8, page 462 Found 1/2" Iron
- 11-12-90 Survey recorded by Harold Elrich 18986 in liber 9, page 245 Found 1/2" Iron

B. Description of corner evidence found and/or method applied in restoring or reestablishing corner:

Found 1/2" Rebar in centerline of Bishop Road (gravel). No occupation to the East.

Witnesses: from items 2 and 3 above.

- N 25° W 35.71' Found West end 18" culvert
- N 30° E 39.7' Found East end 18" culvert
- S 45° E 48.51' Found nail pw'r pole

Distances: North to M-3 Dryden Township GLO 1.1 chs or 72.7 feet; 87.60' Elrich L9, P245; 87.60 feet measured  
South to M-4 Dryden Township 2546.50 feet measured


C. Description of monument for corner and accessories established to perpetuate locating the position of the corner:

Placed standard Lapeer County Remonumentation cap stamped "A 4 17635" on Found 1/2" rebar ..

- Az 20° 132.55' Set PK with Lapeer County tag in NW face corner fence post
- Az 140° 48.40' Found PK, Set PK with Lapeer County tag in SW face utility pole
- Az 195° 71.13' Set PK with Lapeer County tag in E face Quad 4" Ash.
- Az 345° 124.47' Set PK with Lapeer County tag in W face 15" Ash

Signed by William E. Soderberg Date 12-19-96

Surveyor's Michigan License No. 17635

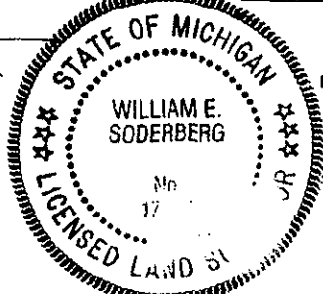

PEER GROUP  
APPROVED LAND CORNER  
PA 345 OF 1990  
LAPEER COUNTY  
RAY DAVIS P.S. CO. SURVEYOR  
DATE 7-16-96

FORM APPROVED BY MICHIGAN STATE BOARD OF LAND SURVEYORS, JAN. 28, 1971  
REVISED MAY 14, 1975  
REVISED JAN., 1983

LIBER 0005 PAGE 0364