

**SURVEY &
REMONUMENTATION**

APR 29 1995

COMMISSION LAND CORNER RECORDATION CERTIFICATE
Filing Requirement of Act 74, Mich. P.A. 1970

RECEIVED FOR RECORD

95 NOV 22 PH 3: 57

LIBER NO. 005 PAGE NO. 300
Melissa DeYoung 301
REGISTER OF DEEDS
LAPEER COUNTY MICHIGAN

For corners in

<u>LAPEER</u> (County)	Located In:	Corner Code #
	ALMONT TOWNSHIP	
1. Public Land Survey	T <u>6N</u> R <u>12E</u>	<u>A-7</u>
	T _____ R _____	_____
	T _____ R _____	_____
	T _____ R _____	_____
2. Property Controlling in Section	S _____ T _____ R _____	_____
	S _____ T _____ R _____	_____
3. Miscellaneous Property in Sec.	S _____ T _____ R _____	_____
	S _____ T _____ R _____	_____

Register of Deeds Stamp & File Number

4. Lot No. _____, Recorded Plat _____
5. Private Claims _____

I, SHELBY W. MONEY, in a field survey on May 19, 1995 do hereby certify that under requirements of P.A. 74, Michigan P.A. of 1970, the corner points mentioned in lines 1 and 2 above were in conformance with regulations and rules therefore as required in the current manual of survey instructions of the United States Department of the Interior, Bureau of Land Management or by a decree of a Court of Law and /or that the corner points mentioned in lines 3, 4 and 5 above were in conformance with the rules of the Michigan Board of Land Surveyors or by a Decree of a Court of Law, established, re-established, monumented, re-monumented, recovered, found as expressed below:

NOTE: Not more than 4 corners, all in the same town and range, may be recorded on this certificate.

A	B	C	D	E	F	G	H	I	J	K	L
1											
2	6		5		4		3		2		1
3											
4	7		8		9		10		11		12
5											
6	18		17		16		15		14		13
7											
8	19		20		21		22		23		24
9											
10	30		29		28		27		26		25
11											
12	31		32		33		34		35		36
13											

A. Description of original monument and accessories and/or subsequent restoration:

1) GLO	1816	Page 552	Joseph Wampler	Set post
2) LCRC	1975	L. 3, P. 47	Harold Elrich P.S. 18986	Set 1/2" Iron
3) Survey	1975	L. 3, P. 225	Harold Elrich P.S. 18986	Set 1/2" Iron
4) Survey	1975	L. 3, P. 227	Harold Elrich P.S. 18986	Set 1/2" Iron
5) Survey	1975	L. 3, P. 440	Earl E. Gravlin P.S. 23510	Found Iron
6)	1986		Lapeer County Road Commission	Found 1/2" Iron
7) Survey	1986	L. 7, P. 225	Harold Elrich P.S. 18986	Found 1/2" Iron
8) Survey	1989	L. 8, P. 342	Harold Elrich P.S. 18986	Found 1/2" Iron

B. Description of corner evidence found and/or method applied in restoring or reestablishing corner:

Found 1/2" Rebar on the centerline of Bishop Road and 3' north of the centerline of Tubspring Road.


Found Witnesses: None

Distances: GLO 18 lks or 11.88' record A-7 to M-7 (T. 6 N., R. 11E.) North 156.92' measured.
A-7 to M-8 (T. 6 N., R. 11 E.) South 2384.2' measured.
A-7 to A-8 South 2475.3' measured
A-7 to A-6 North 2601.9' measured

C. Description of monument for corner and accessories established to perpetuate locating the position of the corner:

Set Lapeer County Remonumentation Brass Cap stamped A-7; 30092 on found 1/2" rebar

North 156.92' M-7, Dryden Township found 1/2" rebar with Lapeer County Brass Cap stamped M-7; 30092
140° E 49.35' Set PK/ Lapeer County tag in Northeast face of GT box pole
160° 95.23' Set PK/ Lapeer County tag in Southwest face of 10" Spuce
230° 74.90' Set PK/ Lapeer tag in Southeast face of utility pole
325° W 188.05' Set PK/ Lapeer tag in South face clump of 12" Locust

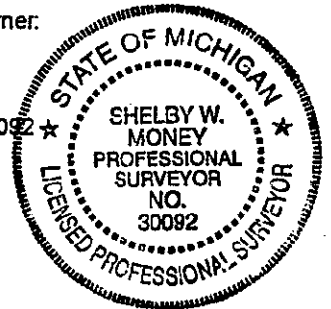

Signed by *Shelby W. Money* Date *Nov 3, 1995*
Surveyor's Michigan License No. 30092

PEER GROUP
APPROVED LAND CORNER
PA 345 OF 1990
LAPEER COUNTY

Ray Davis
RAY DAVIS P.S. CO. SURVEYOR
DATE *7-13-95*

FORM APPROVED BY MICHIGAN STATE BOARD OF LAND SURVEYORS, JAN. 28, 197
REVISED MAY 14, 197
REVISED JAN., 198

LIBER 0005 PAGE 0300

M/A

5 35.1 DRYDEN

2547.4

6 103.2

2548.2

7 156.9 TUBSPRING

2541.1

8 91.1

2562.3

GENERAL SQUIRE
COMMON

2617.15

10 218.0

SECTION 25

SECTION 30

2988.4

11 96.74 HOUGH

MISC D	9.00
REMLC	P0075
REMOVT	2.00

2637.4

SECTION 36

12 SECTION 31

2652.7

13 BORDMAN

T. 6 N., R. 11 E.



T. 6 N., R. 12 E.