

SURVEY & REMONUMENTATION

APR 29 1996

COMMISSION LAND CORNER RECORDATION CERTIFICATE Filing Requirement of Act 74, Mich. P.A. 1970

For corners in

<u>LAPEER</u> (County)	Located In: ALMONT TOWNSHIP	Corner Code # A-10
1. Public Land Survey	T <u>6N</u> R <u>12E</u>	<u>A-10</u>
	T _____ R _____	_____
	T _____ R _____	_____
	T _____ R _____	_____
2. Property Controlling in Section	S _____ T _____ R _____	_____
	S _____ T _____ R _____	_____
3. Miscellaneous Property in Sec.	S _____ T _____ R _____	_____
	S _____ T _____ R _____	_____

RECEIVED FOR RECORD

95 NOV 22 PM 4:00

LIBER NO. 005 PAGE NO. 303

Melissa DeVaugh

REGISTERED DEEDS
LAPEER COUNTY MICHIGAN

Registrar of Deeds Stamp & File Number

4. Lot No. _____, Recorded Plat _____
5. Private Claims _____

I, SHELBY W. MONEY, in a field survey on May 19, 1995 do hereby certify that under requirements of P.A. 74, Michigan P.A. of 1970, the corner points mentioned in lines 1 and 2 above were in conformance with regulations and rules therefore as required in the current manual of survey instructions of the United States Department of the Interior, Bureau of Land Management or by a decree of a Court of Law and/or that the corner points mentioned in lines 3, 4 and 5 above were in conformance with the rules of the Michigan Board of Land Surveyors or by a Decree of a Court of Law; established, re-established, monumented, re-monumented, recovered, found as expressed below:

NOTE: Not more than 4 corners, all in the same town and range, may be recorded on this certificate.

	A	B	C	D	E	F	G	H	I	J	K	L	M
1													
2	6		5		4		3		2		1		
3													
4	7		8		9		10		11		12		
5													
6	18		17		16		15		14		13		
7													
8	19		20		21		22		23		24		
9													
10	30		29		28		27		26		25		
11													
12	31		32		33		34		35		36		
13													

A. Description of original monument and accessories and/or subsequent restoration:

- | | | | |
|-----------|-------------------|-----------------------------------|-----------------|
| 1) GLO | Nothing Set | | |
| 2) Survey | 1972 L. 1, P. 709 | Bernard Henderson P.S. 16043 | Unknown |
| 3) Survey | 1973 L. 2, P. 582 | Robert G. Kay P.S. 14096 | Unknown |
| 4) Survey | 1973 L. 2, P. 583 | Robert G. Kay P.S. 14096 | Unknown |
| 5) LCRC | 1979 L. 3, P. 515 | Harold Elrich P.S. 18986 | Found 1/2" Iron |
| 6) Survey | 1979 L. 5, P. 305 | Harold Elrich P.S. 18986 | Found 1/2" Iron |
| 7) Survey | 1990 L. 8, P. 684 | Harold Elrich P.S. 18986 | Found 1/2" Iron |
| 8) Survey | Unknown | Dunn Construction Engineering Co. | Unknown |

B. Description of corner evidence found and/or method applied in restoring or reestablishing corner:

Found two (2) 1/2" Rebars on the centerline of Bishop Road 1.4' apart Fence line to the East Based on witnesses found below we determined that the north Iron is the corner.

Found Witnesses: From Items 3 thru 6 S 40° W 51.8' Nail in 10" Maple, found stump
From Item 9 East 44.98' Nail Fence Corner

Measurements: GLO: None A-10 to M-10 (T. 6 N., R 11 E.) North 218.0' measured
A-10 to M-9 (T. 6 N., R. 11 E.) South 2770.4' measured


C. Description of monument for corner and accessories established to perpetuate locating the position of the corner:

Set Lapeer County Remonumentation Brass Cap stamped A-10; 30092 on found 1/2" rebar.

South	1.4'	Found 1/2" rebar
90°	44.87'	Found PK, set PK/ Lapeer tag in North face of fence post
50°	140.75'	Northwest corner of house
140°	25.62'	Fd PK, Set PK/ Lapeer tag in Northeast face 10" Thornapple
35°	100.50'	Fd AEW tag, Set PK/ Lapeer tag in Northwest face 44" Willow

PEER GROUP
APPROVED LAND CORNER
PA 345 OF 1990
LAPEER COUNTY

Ray Davis
RAY DAVIS P.S. CO. SURVEYOR
DATE 7-13-95

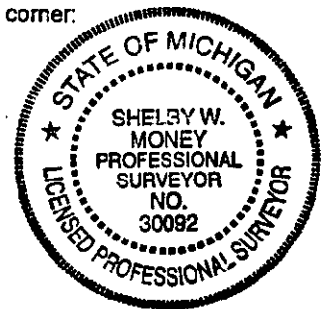

Signed by *Shelby W. Money*
Surveyor's Michigan License No. 30092

Date Nov 3, 1995