

**SURVEY & REMONUMENTATION**

APR 29 1996

**COMMISSION**

**LAND CORNER RECORDATION CERTIFICATE**  
Filing Requirement of Act 74, Mich. P.A. 1970

RECEIVED FOR RECORD

95 NOV 22 PM 4:01

LIBER NO. 005 PAGE NO. 304  
*Shelby W. Money* 305  
REGISTERED DEEDS  
LAPEER COUNTY MICHIGAN

For corners in

LAPEER Located In: Corner Code #  
(County) ALMONT TOWNSHIP

1. Public Land Survey T 6N R 12E A-11  
T \_\_\_\_\_ R \_\_\_\_\_  
T \_\_\_\_\_ R \_\_\_\_\_  
T \_\_\_\_\_ R \_\_\_\_\_

2. Property Controlling S \_\_\_\_\_ T \_\_\_\_\_ R \_\_\_\_\_  
in Section S \_\_\_\_\_ T \_\_\_\_\_ R \_\_\_\_\_

3. Miscellaneous S \_\_\_\_\_ T \_\_\_\_\_ R \_\_\_\_\_  
Property in Sec. S \_\_\_\_\_ T \_\_\_\_\_ R \_\_\_\_\_

Register of Deeds Stamp & File Number

4. Lot No. \_\_\_\_\_, Recorded Plat \_\_\_\_\_  
5. Private Claims \_\_\_\_\_ May 24, 1995

I, SHELBY W. MONEY, in a field survey on May 19, 1995 do hereby certify that under requirements of P.A. 74, Michigan P.A. of 1970, the corner points mentioned in lines 1 and 2 above were in conformance with regulations and rules therefore as required in the current manual of survey instructions of the United States Department of the Interior, Bureau of Land Management or by a decree of a Court of Law and /or that the corner points mentioned in lines 3, 4 and 5 above were in conformance with the rules of the Michigan Board of Land Surveyors or by a Decree of a Court of Law; established, re-established, monumented, re-monumented, recovered, found as expressed below:

**NOTE: Not more than 4 corners, all in the same town and range, may be recorded on this certificate.**

	A	B	C	D	E	F	G	H	I	J	K	L	M
1													
2	6			5			4			3		2	1
3													
4	7			8			9			10		11	12
5													
6	18			17			16			15		14	13
7													
8	19			20			21			22		23	24
9													
10	30			29			28			27		26	25
11													
12	31			32			33			34		35	36
13													

**A. Description of original monument and accessories and/or subsequent restoration:**

- |           |      |              |                                   |                     |  |
|-----------|------|--------------|-----------------------------------|---------------------|--|
| 1) GLO    | 1816 | Page 552     | Joseph Wampler                    | Set post            |  |
| 2) LCRC   | 1973 | L. 2, P. 175 | Harold Elrich P.S. 18986          | Found Iron          |  |
| 3) Survey | 1973 | L. 2, P. 65  | Harold Elrich P.S. 18986          | Found Iron          |  |
| 4) Survey | 1973 | L. 2, P. 582 | Robert Kay P.S. 14096             | Unknown             |  |
| 5) Survey | 1973 | L. 2, P. 583 | Robert Kay P.S. 14096             | Unknown             |  |
| 6) Survey | 1987 | Unrecorded   | Herbert J. Kobs P.S. 14097        | Found 1/2" Iron bar |  |
| 7) Survey | 1990 | L. 8, P. 684 | Harold Elrich P.S. 18986          | Unknown             |  |
| 8) Survey |      | Unrecorded   | Dunn Construction Engineering Co. | Found Iron          |  |

**B. Description of corner evidence found and/or method applied in restoring or reestablishing corner:**

Found 5/8" Rebar with unreadable cap, 3' West and 3' North of center intersection of roads.

Found witnesses: From item 2, 3 Northwest 48.70' Telephone Pole

From item 4, 5 N 60° W 71.34' Nail 24" Maple  
S 45° E 53.20' Nail 28" Cottonwood


PEER GROUP  
APPROVED LAND CORNER  
PA 345 OF 1990  
LAPEER COUNTY  
*Ray Davis*  
RAY DAVIS - S. CO. SURVEYOR  
DATE 7-13-95

GLO: A-11 to M-11 (T. 6 N., R. 11 E.) North 2 chs or 132.0' record 96.74' measure  
A-11 to M-10 (T. 6 N., R. 11 E.) South 2540.7' measured  
A-11 to A-10 North 2867.1' measured (2866.5 Dunn Engineering)

**C. Description of monument for corner and accessories established to perpetuate locating the position of the corner:**


Set 1/2" rebar and Lapeer County Remonumentation Brass Cap stamped A-11; 30092 replacing found 5/8" rebar.

- |        |         |   |
|--------|---------|---|
| 305°   | 69.50'  | Set nail with Lapeer tag in Northeast face 30" Hickory        |
| 340°   | 48.55'  | Found PK, Set nail with Lapeer tag in West face utility pole  |
| 70°    | 115.25' | Set nail with Lapeer tag in Northeast face 24" Locust         |
| 120°   | 91.80'  | Found PK, set nail with Lapeer tag in North face utility pole |
| 155° E | 54.53'  | Set nail with Lapeer tag in Northeast face 36" Locust         |

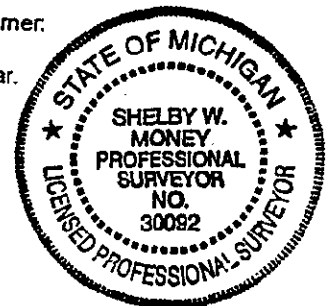

Signed by *Shelby W. Money* Date Nov 3, 1995  
Surveyor's Michigan License No. 30092

M/A

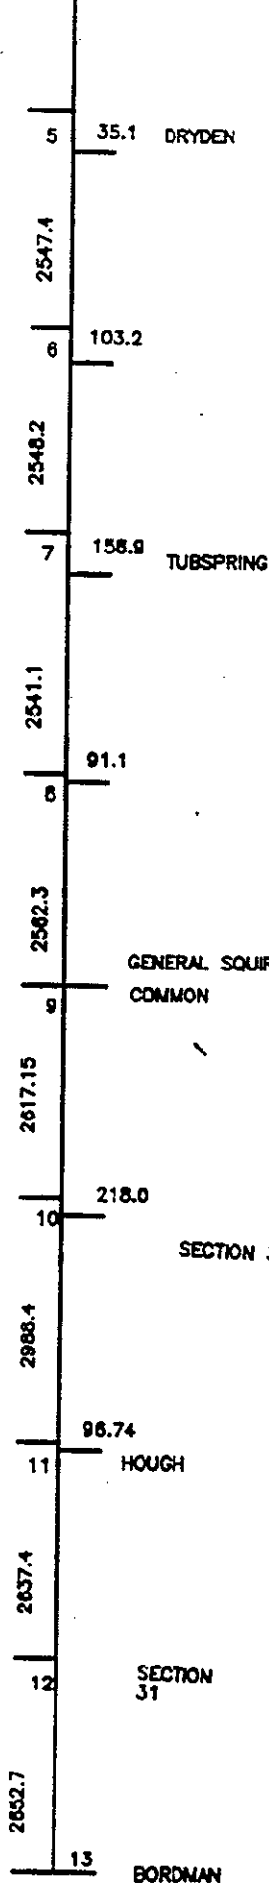

T. 6 N., R. 11 E.

SECTION 25

T. 6 N., R. 12 E.

SECTION 30

MISC C	9.00
REMLC	P0075
REMOHT	2.00

SECTION 38

BORDMAN