

SURVEY &
REMONUMENTATION

MAY 28 1997

COMMISSION

LAND CORNER RECORDATION CERTIFICATE
Filing Requirement of Act 74, Mich. P.A. 1970

RECEIVED RECORD

96 DEC 27 PM 1:05

For corners in

<u>Lapeer</u> (County)	Located in: Airmont Township	Corner Code # G-4
1. Public Land Survey	T <u>6N</u> R <u>12E</u>	<u>G-4</u>
	T ___ R ___	_____
	T ___ R ___	_____
	T ___ R ___	_____
2. Property Controlling in Section	S ___ T ___ R ___	_____
	S ___ T ___ R ___	_____
3. Miscellaneous Property in Sec.	S ___ T ___ R ___	_____
	S ___ T ___ R ___	_____

Hilma D. Vaughn
REGISTER OF DEEDS
LAPEER COUNTY MICHIGAN

Register of Deeds Stamp & File Number

4. Lot No. _____, Recorded Plat _____
5. Private Claims _____

I, William E. Soderberg, in a field survey on May 7, 1996 do hereby certify that under requirements of P.A. 74, Michigan P.A. of 1970, the corner points mentioned in lines 1 and 2 above were in conformance with regulations and rules therefore as required in the current manual of survey instructions of the United States Department of the Interior, Bureau of Land Management or by a decree of a Court of Law and /or that the corner points mentioned in lines 3, 4 and 5 above were in conformance with the rules of the Michigan Board of Land Surveyors or by a Decree of a Court of Law; established, re-established, monumented, re-monumented, recovered, found as expressed below:

NOTE: Not more than 4 corners, all in the same town and range, may be recorded on this certificate.

	A	B	C	D	E	F	G	H	I	J	K	L	M
1													
2	6		5		4		3		2		1		
3													
4	7		8		9		10		11		12		
5													
6	18		17		16		15		14		13		
7													
8	19		20		21		22		23		24		
9													
10	30		29		28		27		26		25		
11													
12	31		32		33		34		35		36		
13													

- A. Description of original monument and accessories and/or subsequent restoration:
1. Joseph Wampler, D.S. in 1818 Set post. No witnesses left.
 2. 10-27-76 Recorded survey by Robert Kay 14095 in liber 3, page 871 found unknown.
 3. 9-1-80 Recorded Survey by Earl Gravlin 23510 in liber 5, page 914 found 1/2" Iron.
 4. 10-2-90 Recorded Survey by Earl Gravlin. 23510 in liber 9 page 84, found 1/2" Iron
 5. 9-7-94 Recorded Survey by Jim Bailey 33968 in liber 10, page 598, found 1/2" Iron

B. Description of corner evidence found and/or method applied in restoring or reestablishing corner:

Found 1/2" rebar in the centerline of Howland Road, gravel. Fence line to West is 2.5' South of Iron. No occupation to East.

Witnesses: from items 2, 3, 4 and 5 above
S 70° W 21.63' Found nail in 8" Cedar
N 30° E. 76.93' Found nail in 6" Cedar

Distances:
North to G-3 GLO 40 chs or 2640 feet; 2642.58 feet Gravlin L5, P 914
2643.41 feet Kay L3, P 871; 2642.00 feet Bailey L10, P 598; 2642.70 feet measured.
South to G-5 GLO 40 chs or 2640 feet; 2650.02 feet Gravlin L9, P84; 2650.84 feet measured.


C. Description of monument for corner and accessories established to perpetuate locating the position of the corner:

Placed standard Lapeer County Remonumentation cap stamped "G 5 17635" on existing 1/2" rebar.

- Az 25° 76.79' Found PK, Set nail with Lapeer County tag in NW face 10" Cedar.
- Az 150° 40.33' Found nail, set Lapeer tag/ PK nail in southern limb of 6" Apple.
- Az 270° 21.71' Found nail, set PK with Lapeer County tag in South face 6" Cedar
- Az 310° 26.10' Set PK nail with Lapeer County tag in SW face 8" Cedar.

Signed by William E. Soderberg Date 12-19-96

Surveyor's Michigan License No. 17635

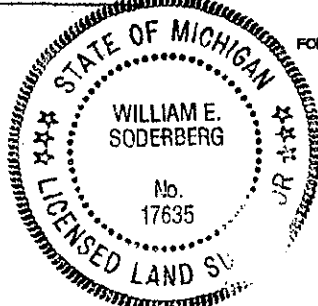

FORM APPROVED BY MICHIGAN STATE BOARD OF LAND SURVEYORS, JAN. 28, 1971
REVISED MAY 14, 1975
REVISED JAN., 1983

PEER GROUP
APPROVED LAND CORNER
PA 345 OF 1990
LAPEER COUNTY

Ray Davis
RAY DAVIS P.S. CO. SURVEYOR
DATE 7-16-96