

SURVEY & REMONUMENTATION

MAY 28 1997

COMMISSION

LAND CORNER RECORDATION CERTIFICATE
Filing Requirement of Act 74, Mich. P.A. 1970

RECEIVED FOR RECORD
96 DEC 27 PM 1:06

For corners in

Table with columns: Lapeer (County), Located in (Almont Township), Corner Code # (G-5). Rows include Public Land Survey, Property Controlling in Section, and Miscellaneous Property in Sec.

REGISTER OF DEEDS
LAPEER COUNTY MICHIGAN

Register of Deeds Stamp & File Number

4. Lot No. , Recorded Plat
5. Private Claims

Grid table with columns A-M and rows 1-13. A dot is marked at the intersection of column G and row 5.

I, William E. Soderberg, in a field survey on May 7, 1996 do hereby certify that under requirements of P.A. 74, Michigan P.A. of 1970, the corner points mentioned in lines 1 and 2 above were in conformance with regulations and rules therefore as required in the current manual of survey instructions of the United States Department of the Interior, Bureau of Land Management or by a decree of a Court of Law and/or that the corner points mentioned in lines 3, 4 and 5 above were in conformance with the rules of the Michigan Board of Land Surveyors or by a Decree of a Court of Law; established, re-established, monumented, re-monumented, recovered, found as expressed below:

NOTE: Not more that 4 corners, all in the same town and range, may be recorded on this certificate.

- A. Description of original monument and accessories and/or subsequent restoration:
1. Joseph Wampler, D.S. in 1818 Set post. No witnesses left.
2. 4-24-73 LCRC by Harold Elrich 18986 Liber 2, Page 171 found monument box
3. 4-9-74 Recorded survey by Bernard Henderson 16043 in liber 2, page 747, found moument box..
4. 10-7-85 Recorded survey by Harold Elrich 18986 in liber 7, page 126 found monument box.
5. 4-28-86 Recorded Survey by Bernard Henderson. 16043 in liber 7, page 343 found unknown.
6. 10-2-90 Recorded Survey by Earl Gravlin. 23510 in liber 9 page 84, found Iron in monument box
7. 3-29-93 Recorded Survey by Haroldt Elrich 18986 in liber 10, page 116, found Iron in monument box.

B. Description of corner evidence found and/or method applied in restoring or reestablishing corner:

Found 1/2" rebar in monument box at the centerline of Dryden Road and Howland Road. Dryden Road is asphalt and Howland Road is gravel.

Witnesses: from items 2, 3, 5, 6 and 7 above
S 30° E 64.31' Power Pole

Distances:
North to G-4 GLO 40 chs or 2640 feet; 2650.02 feet Gravlin L9, P 84; 2650.84 feet measured.
East to H-5 GLO 40 chs or 2640 feet; 2621.85 feet measured.


C. Description of monument for corner and accessories established to perpetuate locating the position of the corner:

Placed standard Lapeer County Remonumentation cap stamped "G 5 17635" on existing 1/2" rebar in existing monument box.

- Az 30° 64.31' Set nail with Lapeer County tag in NW face 10" Maple.
Az 155° 64.34' Found PK/washer, set Lapeer tag/ PK nail in East face utility pole.
Az 195° 140.09' Set PK with Lapeer County tag in East face 24" Osage
Az 315° 101.57' SE corner foundation @ wood trim at house #7491

Signed by [Signature] Date 12-19-96

Surveyor's Michigan License No. 17635

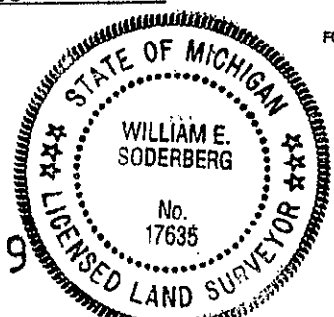

FORM APPROVED BY MICHIGAN STATE BOARD OF LAND SURVEYORS, JAN. 28, 1971
PEER GROUP MAY 14, 1975
REVISED JAN. 1983

APPROVED LAND CORNER
PA 345 OF 1990
LAPEER COUNTY

[Signature]
RAY OAVIS P.S. CO. SURVEYOR
DATE 7-16-96

LIBER 0005 PAGE 0369