

**SURVEY & REMONUMENTATION**

1993

**COMMISSION**

**REMONUMENTATION  
LAND CORNER RECORDATION CERTIFICATE  
Filing Requirement of Act 74, Mich. P.A. 1970**

RECEIVED FOR RECORD

93 DEC 22 PM 2:44

LIBER # 5 PAGE NO. 9  
Shelby W. Money  
REGISTERED PROFESSIONAL SURVEYOR  
LAPEER MICHIGAN

For corners in

LAPEER  
(County)

Located In: Almont Township Corner Code # M-10

- |                                       |                          |             |
|---------------------------------------|--------------------------|-------------|
| 1. Public Land Survey                 | T <u>6N</u> R <u>12E</u> | <u>M-10</u> |
|                                       | T _____ R _____          | _____       |
|                                       | T _____ R _____          | _____       |
|                                       | T _____ R _____          | _____       |
| 2. Property Controlling in Section    | S _____ T _____ R _____  | _____       |
|                                       | S _____ T _____ R _____  | _____       |
| 3. Miscellaneous Property in Sec.     | S _____ T _____ R _____  | _____       |
|                                       | S _____ T _____ R _____  | _____       |
| 4. Lot No. _____, Recorded Plat _____ |                          |             |
| 5. Private Claims _____               |                          |             |

Register of Deeds Stamp & File Number

I, Shelby W. Money, in a field survey on October 12, 19 93, do hereby certify that under requirements of P.A. 74, Michigan P.A. of 1970, the corner points mentioned in lines 1 and 2 above were in conformance with regulations and rules therefore as required in the current manual of survey instructions of the United States Department of the Interior, Bureau of Land Management or by a decree of a Court of Law and/or that the corner points mentioned in lines 3, 4 and 5 above were in conformance with the rules of the Michigan Board of Land Surveyors or by a Decree of a Court of Law; established, re-established, monumented, re-monumented, recovered, found as expressed below:

**NOTE: Not more than 4 corners, all in the same town and range, may be recorded on this certificate.**

A	B	C	D	E	F	G	H	I	J	K	L	M
2	6	5	4	3	2	1						
3												
4	7	8	9	10	11	12						
5												
6	18	17	16	15	14	13						
7												
8	19	20	21	22	23	24						
9												
10	30	29	28	27	26	25						
11												
12	31	32	33	34	35	36						
13												

A. Description of original monument and accessories and/or subsequent restoration:

Post G.L.O. notes page 527  
L.C.R.C. L.4 P.85 by Kobs (1984) Found 1/2" bar

B. Description of corner evidence found and/or method applied in restoring or reestablishing corner:


Found 1/2" Rebar, 6" deep, in field  
Fence lines west and north  
Maple tree west 53'± (no nail)  
Maple tree south southeast 35'± (no nail)

C. Description of monument for corner and accessories established to perpetuate locating the position of the corner:

West 53.11' Set Lapeer tag/nail in north face of 10" Maple tree  
S 05° E 34.85' Set Lapeer tag/nail in west face of 16" Maple tree  
S 10° W 68.70' Set Lapeer tag/nail in west face of 24" Oak tree  
N 60° W 29.82' Set Lapeer tag/nail in north face of triple 8" Elm tree  
S 55° E 43.10' the northeast corner of wood deck on pond

SET LAPEER COUNTY REMONUMENTATION BRASS CAP MARKED 30092 / M-10 OVER EXISTING IRON

Signed by Shelby W. Money Date December 21,  
Surveyor's Michigan License No. 30092

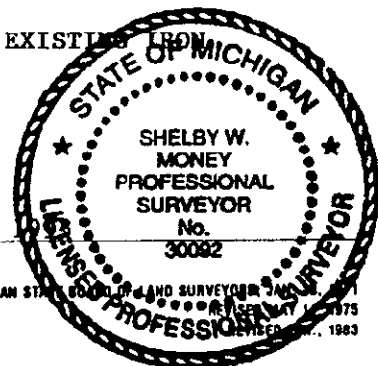

FORM APPROVED BY MICHIGAN STATE BOARD OF LAND SURVEYORS JAN 1 1975