

**SURVEY &
REMONUMENTATION**

MAR 23 2000

SECTION

REMONUMENTATION

LAND CORNER RECORDATION CERTIFICATE


Filing Requirement of Act 74, Mich. P.A. 1970

RECEIVED FOR RECORD

00 FEB 10 PM 2:16

For corners in

<u>LAPEER</u>	Located In:	Corner Code #
(County)	ELBA TWP	
1. Public Land Survey	T <u>7</u> N R <u>9</u> E	<u>A-1</u>
	T _____ R _____	_____
	T _____ R _____	_____
	T _____ R _____	_____
2. Property Controlling in Section	S _____ T _____ R _____	_____
	S _____ T _____ R _____	_____
3. Miscellaneous Property in Sec.	S _____ T _____ R _____	_____
	S _____ T _____ R _____	_____

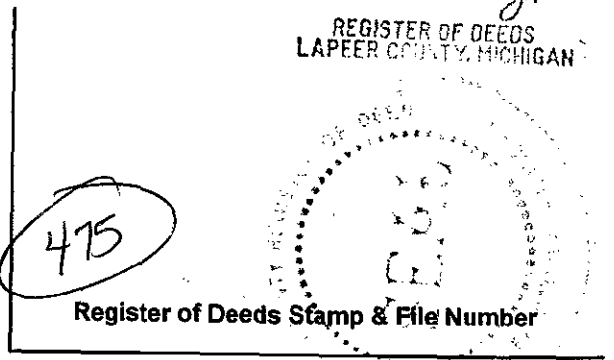

4. Lot No. _____, Recorded Plat _____
5. Private Claims _____

	A	B	C	D	E	F	G	H	I	J	K	L	M
1													
2	6	5	4	3	2	1							
3													
4	7	8	9	10	11	12							
5													
6	18	17	16	15	14	13							
7													
8	19	20	21	22	23	24							
9													
10	30	29	28	27	26	25							
11													
12	31	32	33	34	35	36							
13													

I, MICHAEL G. HAY, in a field survey on AUGUST 22, 1999, do hereby certify that under requirements of P.A. 74, Michigan P.A. of 1970, the corner points mentioned in lines 1 and 2 above were in conformance with regulations and rules therefore as required in the current manual of survey instructions of the United States Department of the Interior, Bureau of Land Management or by a decree of a Court of Law and/or that the corner points mentioned in lines 3, 4 and 5 above were in conformance with the rules of the Michigan Board of Land Surveyors or by a Decree of a Court of Law; established, re-established, monumented, re-monumented, recovered, found as expressed below:

NOTE: Not more than 4 corners, all in the same town and range, may be recorded on this certificate.

A. Description of original monument and accessories and/or subsequent restoration:
1822- JOSEPH WAMPLER D.S. SET POST FOR TOWN 7 & 8 NORTH-RANGE 9 EAST
1866- GILBERT BATES C.S. STONE 16 12 6 CROCKERY SMALL STONES

PEER GROUP
APPROVED LAND CORNER
PA 245 OF 1990
LAPEER COUNTY
[Signature]
RAY DAVIS P.S. CO. SURVEYOR
DATE 1-22-1999

B. Description of corner evidence found and/or method applied in restoring or reestablishing corner:
1999- MICHAEL G. HAY P.S. 41101 FOUND 5/8" IRON IN MON BOX IN CENTERLINE OF OREGON AND WASHBURN ROADS.
A-1 TO B-1 2240.82' (M)

C. Description of monument for corner and accessories established to perpetuate locating the position of the corner:
SET STANDARD REMONUMENTATION CAP ON 1/2" IRON IN MONUMENT BOX
WEST 30.79 TAG 40162 IN NORTH FACE OF 12" TWIN CHERRY
S 45 E 59.46' TAG 40162 IN NORTHEAST FACE OF 18" SCOTCH PINE
N 30 E 67.86' TAG 40162 IN SOUTHEAST FACE OF POWER POLE
N 65 E 72.32' TAG 40162 IN SOUTH FACE OF 30" MAPLE



CORNER IS COMMON TO A-13, T8N-R9E, OREGON TOWNSHIP.

Signed by Michael G. Hay Date 1-11-2000
Surveyor's Michigan License No. 41101