SURVEY &
REMONUMENTATION

1993

COMMISSION

REMONUMENTATION

LAND CORNER RECORDATION CERTIFICATE

Filing Requirement of Act 74, Mich. P.A. 1970

RECEIVED FOR RECORD

93 DEC 30 AM 10: 13

LIBER NO. 5 PAGE NO. 45

Melissa Miles
REGISTER OF DEEDS
LAPEER COUNTY, MICHIGAN

For corners in

LAPEER
(County)

	Located In:	Corner Code #
1. Public Land Survey	T 7 N R 9 E	M-10
	T ___ R ___	
	T ___ R ___	
	T ___ R ___	
2. Property Controlling	S ___ T ___ R ___	
in Section	S ___ T ___ R ___	
3. Miscellaneous	S ___ T ___ R ___	
Property in Sec.	S ___ T ___ R ___	

Register of Deeds Stamp & File Number

4. Lot No. _____, Recorded Plat _____
5. Private Claims _____

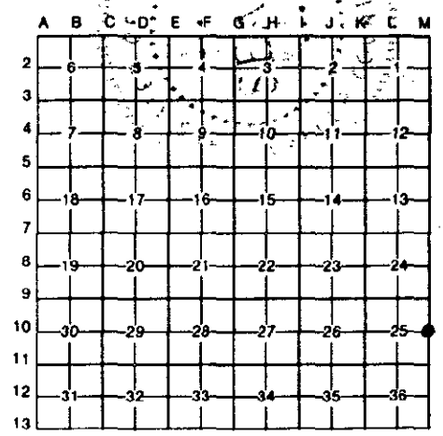

I, Huston K. Kennedy, in a field survey on November, 19 93, do hereby certify that under requirements of P.A. 74, Michigan P.A. of 1970, the corner points mentioned in lines 1 and 2 above were in conformance with regulations and rules therefore as required in the current manual of survey instructions of the United States Department of the Interior, Bureau of Land Management or by a decree of a Court of Law and/or that the corner points mentioned in lines 3, 4 and 5 above were in conformance with the rules of the Michigan Board of Land Surveyors or by a Decree of a Court of Law; established, re-established, monumented, re-monumented, recovered, found as expressed below:

NOTE: Not more than 4 corners, all in the same town and range, may be recorded on this certificate.

A. Description of original monument and accessories and/or subsequent restoration:

1817 GLO - Wampler, D.S.; Set 1/2 mile post; 6" ? S57°W 41 lks., 12" Black Oak N35°W 39 lks.
1972 Henderson, P.S. #16043; LCRC L.2, Pg.65 - Fnd 1/2" iron rod
1973 Mitchell, P.S. #6936; LCRC L.2, Pg.119-120 - Fnd 3/4" iron rod
1977 Elrich P.S. #18986; Survey L.4, Pg227-228 - Fnd iron rod; Same wits as 1972 LCRC
1983 Elrich, P.S.#18986; Survey L.6, Pg.440-441 - Fnd iron rod
1984 Henderson, P.S. #16043; Survey L.6, Pg.686-687 - Fnd iron; Same wits as 1983 survey
1992 Elrich, P.S. #18986; Survey L.9, Pg.727 - Fnd iron rod; Same wits as 1983 survey

B. Description of corner evidence found and/or method applied in restoring or reestablishing corner:

1993 Kennedy Surveying, Inc. - Kennedy, P.S. #17623 - Fnd 1/2" iron rod in center of Baldwin Road and the center of Merwin Road. Both are gravel roads.
Found 2 previous witness points that are still existing. They were used to recover the found 1/2" iron rod.

I accepted the found 1/2" iron rod as the best evidence of the original corner position.

C. Description of monument for corner and accessories established to perpetuate locating the position of the corner:

M-10 1/2" x 24" iron rod with 3" diameter brass cap
N55°W 92.55' Set nail w/remon. tag South face Power Pole
N77°W 121.80' Set nail w/remon. tag South face 15" Hickory
S78°W 165.55' Set nail w/remon. tag North face 9", 10", 14" Triple Elm
S21°E 98.92' Set nail w/remon. tag West face 9" Hickory
S54°E 154.13' Set nail w/remon. tag North face 15" Oak

STATE OF MICHIGAN
HUSTON KENNEDY
LAND SURVEYOR
REGISTERED LAND SURVEYOR

Signed by Huston K. Kennedy Date 11/24/93

Surveyor's Michigan License No. 17623

FORM APPROVED BY MICHIGAN STATE BOARD OF LAND SURVEYORS, JAN. 28, 1971
REVISED MAY 14, 1975
REVISED JAN., 1983