

1993

COMMISSION

REMONUMENTATION
LAND CORNER RECORDATION CERTIFICATE
Filing Requirement of Act 74, Mich. P.A. 1970

For corners in

LAPEER
(County)

Located In:

Corner Code #

- 1. Public Land Survey T 7 N R 9 E M-11
- T R
- T R
- T R
- 2. Property Controlling S T R
- in Section S T R
- 3. Miscellaneous S T R
- Property in Sec. S T R
- 4. Lot No. _____, Recorded Plat _____
- 5. Private Claims _____

RECEIVED FOR RECORD

93 DEC 30 AM 10:14

LIBER NO 5 PAGE NO 46
Melissa Miles
REGISTER OF DEEDS
LAPEER COUNTY MICHIGAN

Register of Deeds Stamp & File Number

I, Huston K. Kennedy, in a field survey on November, 19 93, do hereby certify that under requirements of P.A. 74, Michigan P.A. of 1970, the corner points mentioned in lines 1 and 2 above were in conformance with regulations and rules therefore as required in the current manual of survey instructions of the United States Department of the Interior, Bureau of Land Management or by a decree of a Court of Law and/or that the corner points mentioned in lines 3, 4 and 5 above were in conformance with the rules of the Michigan Board of Land Surveyors or by a Decree of a Court of Law; established, re-established, monumented, re-monumented, recovered, found as expressed below:

NOTE: Not more than 4 corners, all in the same town and range, may be recorded on this certificate.

	A	B	C	D	E	F	G	H	I	J	K	L	M
2	6		5		4		3		2				
3													
4	7		8		9		10		11		12		
5													
6	18		17		16		15		14		13		
7													
8	19		20		21		22		23		24		
9													
10	30		29		28		27		26		25		
11													
12	31		32		33		34		35		36		
13													

A. Description of original monument and accessories and/or subsequent restoration:

1817 GLO - Wampler, D.S.; Set post; 32" White Oak S33°W 49lks; 36" ? N04°W 68 lks
1974 Swarts P.S. #16945; LCRC L.2, Pg. 741 - Fd. 1/2" iron rod


B. Description of corner evidence found and/or method applied in restoring or reestablishing corner:

1993 Kennedy surveying, Inc. - Kennedy P.S. #17623 - Fnd 1/2" iron rod in center of Baldwin Road, which is gravel. There is a fence/tree line to the West.
Found 5/8" iron rod as a witness point an witness trees from LCRC that are still existing. They were used to recover the found 1/2" iron rod.

I accepted the found 1/2" iron rod as the best evidence of the original corner position.

C. Description of monument for corner and accessories established to perpetuate locating the position of the corner:

M-11 1/2" x 24" iron rod with 3" diameter brass cap
N27°02'E 69.04' Set nail w/remon. tag West face 10" Elm
N22°41'W 81.85' Set nail w/remon. tag East face Twin Oak
N86°58'W 46.58' Set nail w/remon. tag North face 19" Oak
N52°43'E 36.45' Set nail w/remon. tag North face 9" Elm
S17°41'E 100.83' Set nail w/remon. tag above Kennedy witness West face 17" Hickory

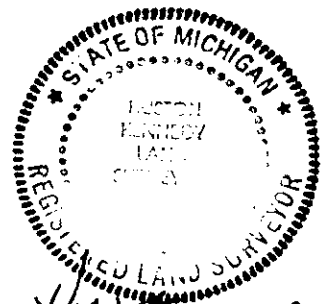

Signed by *Huston K. Kennedy* Date 11/24/93

Surveyor's Michigan License No. 17623