

1993

COMMISSION

REMONUMENTATION
LAND CORNER RECORDATION CERTIFICATE
Filing Requirement of Act 74, Mich. P.A. 1970

For corners in

LAPEER
(County)

Located in:

Corner Code #

- 1. Public Land Survey T 7 N R 9 E M-13
- T _____ R _____
- T _____ R _____
- T _____ R _____
- 2. Property Controlling S _____ T _____ R _____
- in Section S _____ T _____ R _____
- 3. Miscellaneous S _____ T _____ R _____
- Property in Sec. S _____ T _____ R _____
- 4. Lot No. _____, Recorded Plat _____
- 5. Private Claims _____

RECEIVED FOR RECORD

93 DEC 30 AM 10:16

LIBER VOL 5 PAGE NO. 48
Melissa Miles
REGISTERED FIELD SURVEYOR
LAPEER MICHIGAN

Register of Deeds Stamp & File Number

I, Huston K. Kennedy, in a field survey on November, 19 93, do hereby certify that under requirements of P.A. 74, Michigan P.A. of 1970, the corner points mentioned in lines 1 and 2 above were in conformance with regulations and rules therefore as required in the current manual of survey instructions of the United States Department of the Interior, Bureau of Land Management or by a decree of a Court of Law and/or that the corner points mentioned in lines 3, 4 and 5 above were in conformance with the rules of the Michigan Board of Land Surveyors or by a Decree of a Court of Law; established, re-established, monumented, re-monumented, recovered, found as expressed below:

NOTE: Not more than 4 corners, all in the same town and range, may be recorded on this certificate.

	A	B	C	D	E	F	G	H	I	J	K	L	M
2	8		5		4		3		2		1		
3													
4	7		8		9		10		11		12		
5													
6	18		17		16		15		14		13		
7													
8	19		20		21		22		23		24		
9													
10	30		29		28		27		26		25		
11													
12	31		32		33		34		35		36		
13													

A. Description of original monument and accessories and/or subsequent restoration:

- 1817 GLO - Wampler, D.S.; Set post; 11" White Oak S17°W 26 lks; 11" Black Oak N41°E 12 lks
- 1991 Gravlin P.S. #23510; LCRC L.4, Pg. 374 - Fd. 1/2" iron rod
- 1991 Gravlin P.S. #23510; Survey L.9, Pg. 573-575 - Fd. 1/2" iron rod; same wits as 1991 LCRC

B. Description of corner evidence found and/or method applied in restoring or reestablishing corner:


1993 Kennedy Surveying, Inc. - Kennedy P.S. #17623 - Fd. 1/2" iron rod in the center of Baldwin Road to the North and on the East edge of Baldwin Road to the South, and in the center of Sutton Road. Both are gravel roads.

The stop sign is the only witness existing. It was used to recover the found 1/2" iron rod.

I accepted the found 1/2" iron rod as the best evidence of the original corner position.

C. Description of monument for corner and accessories established to perpetuate locating the position of the corner:

- M-13 - 1/2' x 24" iron rod with 3" diameter brass cap.
- N11°W - 175.70 Ft. Set nail w/ remon. tag below existing witness in W face power pole
- S57°E - 63.41 Ft. Set nail w/remon. tag in NW face 4" Elm in clump
- S69°W - 91.82 Ft. Set nail w/remon. tag in N face power pole
- N59°E - 102.05 Ft. Set nail w/remon. tag in N face 5" Elm
- N25°E - 100.07 Ft. Set nail w/remon. tag in NW face Twin Elm

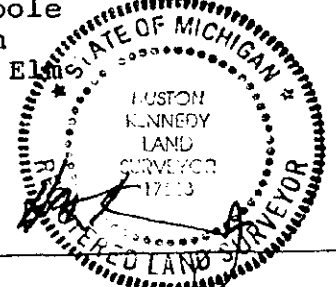

Signed by Huston K. Kennedy

Date 11/24/93

Surveyor's Michigan License No. 17623