

MAR 29 1999

LAND CORNER RECORDATION CERTIFICATE

Filing Requirement of Act 74, Mich. P.A. 1970

For corners in

LAPEER (County)

Located In: Lapeer

Corner Code # A-2

RECEIVED FOR RECORD 99 JAN -6 PM 1:44

Melissa DeVaugh REGISTER OF DEEDS LAPEER MICHIGAN

Register of Deeds Stamp & File Number

- 1. Public Land Survey T 7 N R 10 E A-2
2. Property Controlling in Section S T R
3. Miscellaneous Property in Sec. S T R

- 4. Lot No. Recorded Plat
5. Private Claims

I, MICHAEL G. HAY P.S., in a field survey on MARCH 3 19 98, do hereby certify that under requirements of P.A. 74, Michigan P.A. of 1970, the corner points mentioned in lines 1 and 2 above were in conformance with regulations and rules therefore as required in the current manual of survey instructions of the United States Department of the Interior, Bureau of Land Management or by a decree of a Court of Law and/or that the corner points mentioned in lines 3, 4 and 5 above were in conformance with the rules of the Michigan Board of Land Surveyors or by a Decree of a Court of Law; established, re-established, monumented, re-monumented, recovered, found as expressed below:

NOTE: Not more than 2 corners, all in the same town and range, may be recorded on this certificate.

A. Description of original monument and accessories and/or subsequent restoration:

NO CORNER SET - ORIGINAL SURVEY

1866 GILBERT BATES L.S. STONE 19-9-3 BRICK W OAK 6 N 24 W 107, W OAK 3 N 79 1/4 E 146
1984 PETER BEAVER P.S. 25828 (LCRC) LIBER 4, PAGE 100 SET 1/2" REROD IN BLACKTOP WITH THE FOLLOWING ACCESSORIES

- P.K. & BRASS TAG S.S. P.P. S 75 E 31.10', P.K. & BRASS TAG NW LEG "OAKDALE" SIGN S 45 E 71.85', P.K. & BRASS TAG E.S. P.P. N 30 W 101.45', P.K. & BRASS TAG NW SIDE 15" RED CEDAR S 40 W 126.17', NW CORNER AT TOP CONCRETE FOOTING OF LIGHT POLE NO. 24 S 75 W 42.78', E 1/4 CORNER, SEC. 1, T7N-R9E, NORTHERLY 296.05'

1987 PETER BEAVER P.S. 25828, SURVEY LIBER 8, PAGE 264-265 (WITNESSES SAME AS ABOVE)
1998 MICHAEL G. HAY P.S. 41101 FOUND 1/2" IRON IN ASPHALT (WITNESSES SAME AS ABOVE)


B. Description of corner evidence found and/or method applied in restoring or reestablishing corner:

1998 MICHAEL G. HAY P.S. 41101 FOUND 1/2" IRON IN ASPHALT AT ENTRANCE AT INTERSECTION OF MILLVILLE ROAD AND M-21. IRON STRAIGHT. FOUND TWO WITNESSES THAT MEASURED CLOSE TO DISTANCE.

- A-2 TO M-2 296.23 FEET (M)
A-2 TO A-3 2387.55 FEET (M)

C. Description of monument for corner and accessories established to perpetuate locating the position of the corner: SET REMONUMENTATION CAP ON 1/2" IRON

- N 25 W 101.61 FEET P.K. & BRASS TAG IN EAST SIDE - POWER POLE
S 65 E 30.92 FEET NAIL & MDOT TAG ON SOUTH SIDE OF GUY POLE
N 35 E 146.23 FEET SW CORNER OF PARTY STORE
N 45 E 172.20 FEET SE CORNER OF PARTY STORE

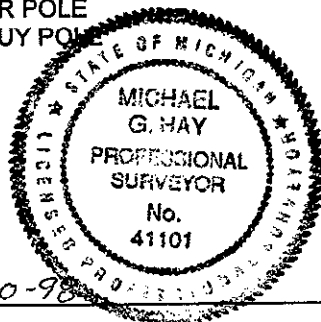

Signed by Michael G. Hay

Date 12-30-98

Surveyor's Michigan License No. 41101