


RECORDED

MAR 29 1999

SECTION

REMONUMENTATION
LAND CORNER RECORDATION CERTIFICATE
Filing Requirement of Act 74, Mich. P.A. 1970

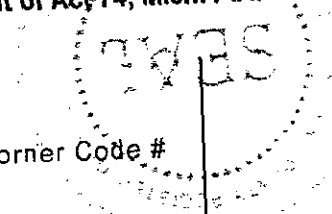

RECEIVED FOR RECORD

99 JAN -6 PM 1:44

Melissa De Vaughn
REGISTER OF DEEDS
LAPEER COUNTY MICHIGAN

450

Register of Deeds Stamp & File Number

For corners in

LAPEER

(County)

Located In:
LAPEER TWP.

Corner Code #

A-7

1. Public Land Survey

T 7 R 10

T R

T R

T R

2. Property Controlling
in Section

S T R

S T R

3. Miscellaneous
Property in Sec.

S T R

S T R

4. Lot No. _____ Recorded Plat _____

5. Private Claims _____

I, MICHAEL G. HAY, in a field survey on MARCH 3, 1998, do hereby certify that under requirements of P.A. 74, Michigan P.A. of 1970, the corner points mentioned in lines 1 and 2 above were in conformance with regulations and rules therefore as required in the current manual of survey instructions of the United States Department of the Interior, Bureau of Land Management or by a decree of a Court of Law and/or that the corner points mentioned in lines 3, 4 and 5 above were in conformance with the rules of the Michigan Board of Land Surveyors or by a Decree of a Court of Law; established, re-established, monumented, re-monumented, recovered, found as expressed below:

NOTE: Not more than 4 corners, all in the same town and range, may be recorded on this certificate.

A. Description of original monument and accessories and/or subsequent restoration:

JOSEPH WAMPLER-SET POST 221 S OF POST-W OAK 25 J41 1/2E 67 DO 12 S31E 66
1979-EARL E. GRAVLIN P.S. 23510 L5 P564 FOUND 3/4" BAR

N80E 26.10' NAIL AND CAP 10" HICKORY
S50E 40.82' NAIL 4X6 POST
S30E 52.85' NAIL 36" OAK
N 151.15 SE COR SEC 13, ELBA TWP.

1981-EARL E. GRAVLIN P.S. 23510 L6 P94 FOUND 3/4" BAR

N80E 26.10' NAIL 10" HICKORY
S50E 40.82' NAIL 4X6 POST
S30E 52.85' NAIL 36" OAK

1991-HAROLD N. ELRICH P.S. 18986 L009 P412-422 FOUND IRON BAR

S30 W 128.50' NAIL IN POWER POLE
S75E 52.30' NAIL IN NORTHERLY GATE POST
N10W 123.80' NAIL IN POWER POLE

CONTINUED ON BACK


B. Description of corner evidence found and/or method applied in restoring or reestablishing corner:

1997-MICHAEL G. HAY P.S. 41101 FOUND 1/2" IRON ROD IN MON BOX 5+/- NORTH OF THE CENTER LINE OF LIPPINCOTT ROAD AND 2+/- WEST OF THE CENTER LINE OF BALDWIN ROAD.

A-7 TO A-8 2645.08' (M)
A-7 TO M-7 NORTH 151.15' (M)

C. Description of monument for corner and accessories established to perpetuate locating the position of the corner:

A-7 SET STANDARD REMONUMENTATION CAP ON FOUND 1/2 IRON IN MONUMENT BOX
S40W 55.10' TO P.K. IN SE FACE OF UTILITY POLE
S20W 127.85' TO P.K. IN SE FACE OF UTILITY POLE
S40E 55.15' TO P.K. IN SW FACE OF UTILITY POLE
NW CORNER OF LIPPENCOTT & BALDWIN 108.28' TO SE HSE CORNER 1494

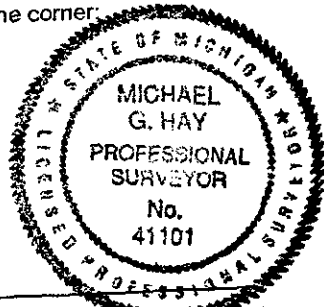

Signed by Michael G. Hay
Surveyor's Michigan License No. 41101

Date 12-23-98

FORM APPROVED BY MICHIGAN STATE BOARD OF LAND SURVEYORS, 1971
REVISED MAY 14, 1975
REVISED JAN., 1983
ADAPTED FOR WORD PROCESSING MARCH, 1983

MAR 29 1999

SECTION

1993-HAROLD N. ELRICH P.S. 18986 L10 P335-336 FOUND IRON BAR
 S30W 128.50' NAIL IN POWER POLE
 S75E 52.30' NAIL IN NORTHERLY GATE POST
 N10W 123.80' NAIL IN POWER POLE

1994-HAROLD N. ELRICH P.S. 18986 L10 P603-604 FOUND IRON BAR
 S30W 128.50' NAIL IN POWER POLE
 S75E 52.30' NAIL IN NORTHERLY GATE POST
 N10W 123.80' NAIL IN POWER POLE

FIELD GROUP
 APPROVED AND FORWARDED

[Signature]

 DATE 09-17-98

MISC D 9.00
 RENLC P0075
 REMONT 2.00