

**SURVEY &  
REMONUMENTATION**

**MAR 13 1998**

**REMONUMENTATION**


**RECEIVED FOR RECORD**

**SECTION**

**LAND CORNER RECORDATION CERTIFICATE 98 FEB 18 PM 2:49**  
Filing Requirement of Act 74, Mich. P.A. 1970

For corners in

<u>Lapeer</u> (County)	Located In: <u>Lapeer Township</u>	Corner Code #
1. Public Land Survey	T <u>7N</u> R <u>10E</u>	<u>C-6</u>
	T _____ R _____	_____
	T _____ R _____	_____
	T _____ R _____	_____
2. Property Controlling in Section	S _____ T _____ R _____	_____
	S _____ T _____ R _____	_____
3. Miscellaneous Property in Sec.	S _____ T _____ R _____	_____
	S _____ T _____ R _____	_____

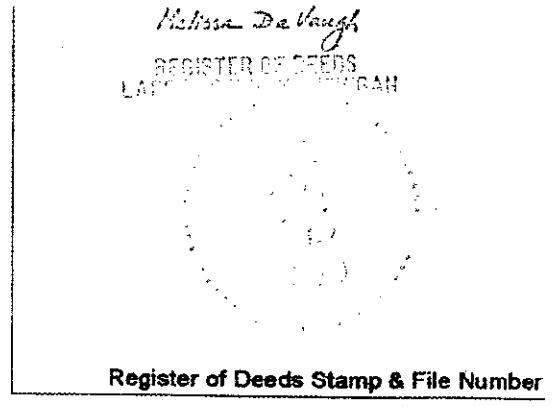

4. Lot No. \_\_\_\_\_, Recorded Plat \_\_\_\_\_  
5. Private Claims \_\_\_\_\_


I, Huston K. Kennedy, in a field survey on 12-2, 1997 do hereby state that under requirements of P.A. 74, Michigan P.A. of 1970, the corner points mentioned in lines 1 and 2 above were in conformance with regulations and rules therefore as required in the current manual of survey instructions of the United States Department of the Interior, Bureau of Land Management or by a decree of a Court of Law and/or that the corner points mentioned in lines 3, 4 and 5 above were in conformance with the rules of the Michigan Board of Land Surveyors or by a Decree of a Court of Law; established, re-established, monumented, recovered, found as expressed below:

**NOTE: Not more than 2 corners, all in the same town and range, may be recorded on this certificate.**

	A	B	C	D	E	F	G	H	I	J	K	L	M
1													
2	6		5		4		3		2		1		
3													
4	7		8		9		10		11		12		
5													
6	16		17		16		15		14		13		
7													
8	19		20		21		22		23		24		
9													
10	30		29		28		27		26		25		
11													
12	31		32		33		34		35		36		
13													

A. Description of original monument and accessories and/or subsequent restoration:

- 1817-GLO Wampler, D.S., Set Post
- 1.) 1980-Henderson, PS #16043; Survey L.5, Pg.729 - Fnd ?
- 2.) 1987-Elrich, PS #18986; Survey L.7, Pg.470 - Fnd ?

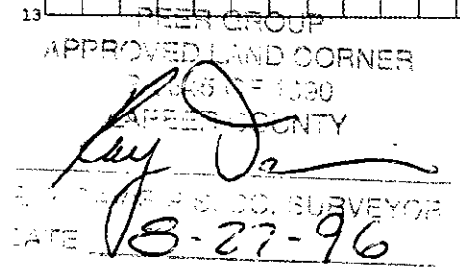

B. Description of corner evidence found and/or method applied in restoring or reestablishing corner:

1996 Kennedy Surveying, Inc. - Kennedy, PS #17623 - Fnd chiseled "+" cut in the concrete median of Lapeer Road (M-24 Highway) extending North & South, which has a concrete surface.

Witnesses from Survey #2 were used to recover and verify the location of the found chiseled "+".

I accepted the found chiseled "+" as the best evidence of the original corner position.

**FIELD MEASUREMENTS BETWEEN**

C-6 to C-7 GLO 40 chains or 2640.00 Ft., 2649.80 Ft. (MEA 1996), 2650.78 Ft. L.5, Pg.729

C. Description of monument for corner and accessories established to perpetuate locating the position of the corner:

- C-6 I replaced the found chiseled "+" with a 1/2" x 24" Iron Rod w/2" diameter brass cap stamped Lapeer County Remonumentation C-6 in a new Monument Box
- N90°E 70.06' "x" top bolt West side of concrete base for overhead sign
- S24°E 220.75' Set PK & Remon Washer NE face Power Pole
- S18°W 205.35' Set PK & Remon Washer SE face Power Pole
- S35°W 55.48' "+" in Sta. 741+00
- S30°E 54.12' "+" in Sta. 741+00     N30°W 61.10' "+" in Sta. 742+00

The selected location is accepted by me and is generally accepted by Professional Surveyors as the best available evidence of the position of the original corner.

Signed by: Huston K. Kennedy  
Surveyor's Michigan License No. 17623

Date 12-30-97

