

SURVEY & REMONUMENTATION

APR 29 1996

COMMISSION

**REMONUMENTATION
LAND CORNER RECORDATION CERTIFICATE
Filing Requirement of Act 74, Mich. P.A. 1970**

RECEIVED FOR RECORD

For corners in

<u>Lapeer</u> <small>County</small>	Located In:	Corner Code #
1. Public Land Survey	T <u>7N</u> R <u>10E</u>	<u>M-2</u>
	T _____ R _____	_____
	T _____ R _____	_____
	T _____ R _____	_____
2. Property Controlling in Section	S _____ T _____ R _____	_____
	S _____ T _____ R _____	_____
3. Miscellaneous Property in Sec.	S _____ T _____ R _____	_____
	S _____ T _____ R _____	_____
4. Lot No. _____, Recorded Plat _____		
5. Private Claims _____		

95 OCT -6 PM 1:04
LIBER NO. 005 PAGE NO. 276
Melissa DeVaugh 277
REGISTER OF DEEDS
LAPEER COUNTY, MICHIGAN

Register of Deeds Stamp & File Number

I, HAROLD N. ELRICH, in a field survey on AUGUST 10, 19 95, do hereby certify that under requirements of P.A. 74, Michigan P.A. of 1970, the corner points mentioned in lines 1 and 2 above were in conformance with regulations and rules therofore as required in the current manual of survey instructions of the United States Department of the Interior, Bureau of Land Management or by a decree of a Court of Law and/or that the corner points mentioned in lines 3, 4 and 5 above were in conformance with the rules of the Michigan Board of Land Surveyors or by a Decree of a Court of Law; established, re-established, monumented, re-monumented, recovered, found as expressed below:

A	B	C	D	E	F	G	H	I	J	K	L	M
2	6	5	4	3	2	1						
3												
4	7	3	9	10	11	12						
5												
6	18	17	16	15	14	13						
7												
8	19	20	21	22	23	24						
9												
10	30	29	28	27	26	25						
11												
12	31	32	33	34	35	36						
13												

NOTE: Not more than 4 corners, all in the same town and range, may be recorded on this certificate.

A. Description of original monument and accessories and/or subsequent restoration:

- 1822 WAMPLER D.S. SET 1/2 MILE POST - SUGAR 20" N 83° W 22 LINKS, WHITE OAK 40"
S 18° E 12 LINKS
- 1877 GILBERT BATES - STONE 25.11.9 SMALL STONES - SUGAR S 10° W 131 LINKS, CHERRY 2"
S 82° W 40 LINKS
- 1973 ELRICH P.S. (SURVEY) LIBER 002, PAGE 001 - FOUND 1/2" IRON - N 30° E 27.46 FEET
8" MAPLE, S 45° E 54.55 FEET POWER POLE, S 80° W 31.75 FEET 4" LOCUST
- 1973 ELRICH P.S. LAND CORNER RECORDATION CERTIFICATE - LIBER 002, PAGE 155 FOUND 1/2" IRON
SAME WITNESSES AS 1973 SURVEY
- 1977 ELRICH P.S. (SURVEY) LIBER 004, PAGE 396 FOUND 1/2" IRON - SAME WITNESSES AS
1973 SURVEY (SEE BACK)

B. Description of corner evidence found and/or method applied in restoring or reestablishing corner:

1995 ELRICH P.S. FOUND 1/2" IRON - 1.0 FOOT EAST OF THE CENTERLINE OF FIVE LAKES ROAD. A TREE AND STONE ROW IS WEST OF THE 1/2" IRON FOUND. FOUND FOUR WITNESSES FROM PREVIOUS SURVEYS THAT LOCATE THE 1/2" IRON FOUND. MEASUREMENT TO NORTHEAST CORNER OF SECTION 1 MATCHED DISTANCE FROM PREVIOUS SURVEY. ALSO MEASUREMENT OF 125.22 FEET TO WEST 1/4 CORNER OF SECTION 6, T7N-R11E, ATTICA TOWNSHIP, MATCHED PREVIOUS SURVEYS

ACCEPTED 1/2" IRON FOUND AS BEST LOCATION OF ORIGINAL POSITION OF EAST 1/4 CORNER OF SECTION 1, T7N-R10E, LAPEER TOWNSHIP, LAPEER COUNTY, MICHIGAN


MEASURED REFERENCES - M-2 TO M-1 2875.30 FEET
M-2 TO M-3 2660.25 FEET
M-2 TO L-2 2628.57 FEET

C. Description of monument for corner and accessories established to perpetuate locating the position of the corner:

M-2 PLACED LAPEER COUNTY REMONUMENTATION CAP ON 1/2" IRON FOUND

SET NEW WITNESSES - N 80° W 32.00 FEET P.K. NAIL & WASHER IN 8" ASH
N 30° E 27.46 FEET P.K. NAIL & WASHER IN 18" MAPLE
S 85° E 34.18 FEET P.K. NAIL & WASHER IN TRI-ELM 6", 4", 3"
S 45° E 54.61 FEET P.K. NAIL & WASHER IN UTILITY POLE

Signed by Harold N. Elrich Date 9/26/95
Surveyor's Michigan License No. 18986

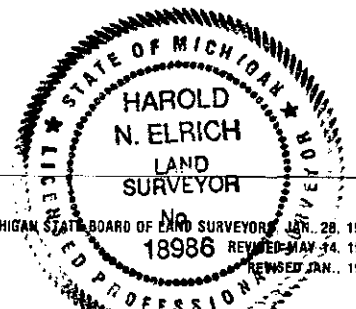


FORM APPROVED BY MICHIGAN STATE BOARD OF LAND SURVEYORS JAN. 28, 1971
REVISED MAY 14, 1975
REVISED JAN., 1983

A. (CONTINUED)

1990 ELRICH P.S. (SURVEY) LIBER 008, PAGE 913 - FOUND 1/2" IRON,
S 45° E 54.61 FEET NAIL IN POWER POLE, N 30° E 27.46 FEET
NAIL IN 16" MAPLE, N 80° W 32.00 FEET NAIL IN 6" ASH, SOUTH
125.22 FEET 1/2" IRON - WEST 1/4 CORNER, SECTION 6, T7N-R11E,

PEER GROUP
APPROVED LAND CORNER
PA 345 OF 1990
LAPEER COUNTY

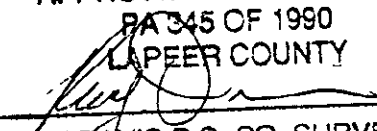
RAY DAVIS P.S. CO. SURVEYOR
DATE 8-31-95

MISC D	9.00
REMLC	P0075
REXONT	2.00