

SURVEY &  
REMONUMENTATION

1993

COMMISSION

REMONUMENTATION  
LAND CORNER RECORDATION CERTIFICATE  
Filing Requirement of Act 74, Mich. P.A. 1970

RECEIVED FOR RECORD

93 DEC 22 PM 2:52

LIBER NO. 5 PAGE NO. 21  
*Melissa Miles*  
REGISTER OF DEEDS  
LANSING, MICHIGAN

For corners in

LAPEER  
County

Located In:

Corner Code #

- |                                       |                          |             |
|---------------------------------------|--------------------------|-------------|
| 1. Public Land Survey                 | T <u>7N</u> R <u>10E</u> | <u>M-10</u> |
|                                       | T _____ R _____          | _____       |
|                                       | T _____ R _____          | _____       |
|                                       | T _____ R _____          | _____       |
| 2. Property Controlling in Section    | S _____ T _____ R _____  | _____       |
|                                       | S _____ T _____ R _____  | _____       |
| 3. Miscellaneous Property in Sec.     | S _____ T _____ R _____  | _____       |
|                                       | S _____ T _____ R _____  | _____       |
| 4. Lot No. _____, Recorded Plat _____ |                          |             |
| 5. Private Claims _____               |                          |             |

Register of Deeds Stamp & File Number

I, HAROLD N. ELRICH, in a field survey on NOVEMBER, 19 93, do hereby certify that under requirements of P.A. 74, Michigan P.A. of 1970, the corner points mentioned in lines 1 and 2 above were in conformance with regulations and rules therefore as required in the current manual of survey instructions of the United States Department of the Interior, Bureau of Land Management or by a decree of a Court of Law and/or that the corner points mentioned in lines 3, 4 and 5 above were in conformance with the rules of the Michigan Board of Land Surveyors or by a Decree of a Court of Law; established, re-established, monumented, re-monumented, recovered, found as expressed below:

**NOTE: Not more than 4 corners, all in the same town and range, may be recorded on this certificate.**

	A	B	C	D	E	F	G	H	I	J	K	L	M
2	6	5	4	3	2	1							
3													
4	7	8	9	10	11	12							
5													
6	18	17	16	15	14	13							
7													
8	19	20	21	22	23	24							
9													
10	30	29	28	27	26	25							
11													
12	31	32	33	34	35	36							
13													

A. Description of original monument and accessories and/or subsequent restoration:

ORIGINAL GLO SURVEY BY JOS. WAMPLER D.S. SET 1/2" MILE POST  
PINE 20" NORTH 80° WEST 18 LINKS & PINE 22" NORTH 16° WEST 32 LINKS

1974 LAND CORNER RECORDATION CERTIFICATE LIBER 002, PAGE 645 FOUND 1/2" IRON ROD  
SOUTH 60.11 FEET TO A-10, T7N-R11E, BROWN P.S. #17613

1981 RECORDED SURVEY LIBER 006, PAGE 254 FOUND 1/2" IRON ROD, SAME THREE WITNESSES  
AS 1974 SURVEY, GRAVLIN P.S. #23510

B. Description of corner evidence found and/or method applied in restoring or reestablishing corner:

1993 NOV. ELRICH P.S. #18986 FOUND 1/2" IRON ROD, FOUND TWO WITNESS TIES THAT  
CLOSELY MATCHED PREVIOUS TIES FROM 1974 LAND CORNER RECORDATION  
CERTIFICATE

ACCEPTED 1/2" IRON ROD AS BEST EVIDENCE OF ORIGINAL POSITION OF EAST 1/4 CORNER  
OF SECTION 25

C. Description of monument for corner and accessories established to perpetuate locating the position of the corner:

**M-10 1/2" IRON ROD WITH REMONUMENTATION CAP**

NORTH 20° EAST 57.64 FEET SET NAIL & REMONUMENTATION TAG IN 30" MAPLE

NORTH 25° WEST 89.71 FEET SET NAIL & REMONUMENTATION TAG IN 10" ELM

SOUTH 80° WEST 36.97 FEET SET NAIL & REMONUMENTATION TAG IN 8" OAK


SOUTH 82° EAST 33.81 FEET SET NAIL & REMONUMENTATION TAG IN 18" OAK

SOUTH 60.11 FEET FOUND 1/2" PIPE A -10 T7N-R11E,

Signed by Harold N. Elrich

Date 12-1-93

Surveyor's Michigan License No. 18986

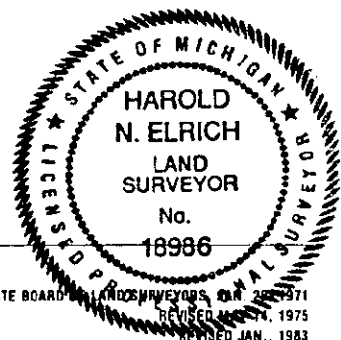

FORM APPROVED BY MICHIGAN STATE BOARD OF LAND SURVEYORS, JAN 28 1971  
REVISED JAN 24 1975  
REVISED JAN. 1983