

SURVEY & REMONUMENTATION

1993

COMMISSION

**REMONUMENTATION
LAND CORNER RECORDATION CERTIFICATE
Filing Requirement of Act 74, Mich. P.A. 1970**

RECEIVED FOR RECORD

93 DEC 22 PM 3:54

LIBER 5 PAGE 23
LAFAYETTE

For corners in

<u>Lapeer</u> (County)	Located in:	Corner Code #
1. Public Land Survey	T <u>7N</u> R <u>10E</u>	<u>M-12</u>
	T _____ R _____	_____
	T _____ R _____	_____
	T _____ R _____	_____
2. Property Controlling in Section	S _____ T _____ R _____	_____
	S _____ T _____ R _____	_____
3. Miscellaneous Property in Sec.	S _____ T _____ R _____	_____
	S _____ T _____ R _____	_____
4. Lot No. _____, Recorded Plat _____		
5. Private Claims _____		

Register of Deeds Stamp & File Number

	A	B	C	D	E	F	G	H	I	J	K	L	M
2	6	5	4	3	2	1							
3													
4	7	8	9	10	11	12							
5													
6	18	17	16	15	14	13							
7													
8	19	20	21	22	23	24							
9													
10	30	29	28	27	26	25							
11													
12	31	32	33	34	35	36							
13													

I, HAROLD N. ELRICH, in a field survey on NOVEMBER, 19 93, do hereby certify that under requirements of P.A. 74, Michigan P.A. of 1970, the corner points mentioned in lines 1 and 2 above were in conformance with regulations and rules therefore as required in the current manual of survey instructions of the United States Department of the Interior, Bureau of Land Management or by a decree of a Court of Law and/or that the corner points mentioned in lines 3, 4 and 5 above were in conformance with the rules of the Michigan Board of Land Surveyors or by a Decree of a Court of Law; established, re-established, monumented, re-monumented, recovered, found as expressed below:


NOTE: Not more than 4 corners, all in the same town and range, may be recorded on this certificate.

A. Description of original monument and accessories and/or subsequent restoration:
 ORIGINAL GLO SURVEY BY JOS. WAMPLER D.S. SET 1/2 MILE CORNER ASPIN 11" COR. TREE
 1874 BATES, STAKE ELM 18" S 63 1/2° W 41 LINKS & MAPLE STUMP 24" N 62° E 40 LINKS
 1973 RECORDED SURVEY LIBER 002, PAGES 555-558 FOUND 1/2" IRON ROD ELRICH P.S. #18986
 1974 LAND CORNER RECORDATION CERT. LIBER 002, PAGE 499, SAME THREE WITNESS AS 1973 SURVEY ELRICH P.S. #18986

B. Description of corner evidence found and/or method applied in restoring or reestablishing corner:
 1993 NOV. ELRICH P.S. #18986 FOUND 1/2" IRON ROD ON FIVE LAKES ROAD OPPOSITE EXISTING CONCRETE PILLAR & FENCE TO WEST
 FOUND ONE WITNESS FROM 1973 SURVEY AND 1974 LAND CORNER RECORDATION CERTIFICATE
 ACCEPTED 1/2" IRON AS BEST EVIDENCE OF ORIGINAL POSITION OF EAST 1/4 CORNER OF SECTION 36

C. Description of monument for corner and accessories established to perpetuate locating the position of the corner:
 M-12 1/2" IRON ROD WITH REMONUMENTATION CAP
 NORTH 65° EAST 28.20 FEET SET NAIL & REMONUMENTATION TAG IN TWIN OAK 4" & 6"
 SOUTH 15° EAST 39.41 FEET SET NAIL & REMONUMENTATION TAG IN 20" OAK
 WEST 30.21 FEET SOUTHEAST CORNER OF CONCRETE PILLAR
 NORTH 40° WEST 56.43 FEET SET NAIL & REMONUMENTATION TAG IN 30" OAK
 SOUTH 50.05 FEET FOUND 1/2" IRON ROD A-12 T7N-R11E

Signed by Harold N. Elrich Date 12-1-93
 Surveyor's Michigan License No. 18986

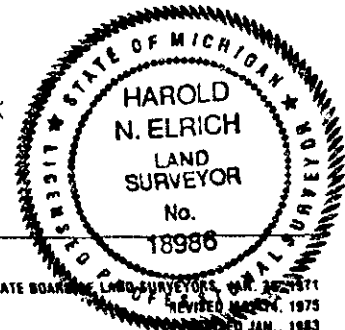

FORM APPROVED BY MICHIGAN STATE BOARD OF LAND SURVEYORS, M.S. 2025711 REVISED MARCH, 1975 REPEALED JAN., 1983