

**SURVEY &
REMONUMENTATION**

MAR 13 1998

**REMONUMENTATION
LAND CORNER RECORDATION CERTIFICATE
Filing Requirement of Act 74, Mich. P.A. 1970**


RECEIVED FOR RECORD

98 FEB 25 PM 3:04

SECTION

For corners in

Section	Located In:	Corner Code #
1 Public Land Survey	T <u>7N</u> R <u>11E</u>	<u>A-2</u>
	T _____ R _____	_____
	T _____ R _____	_____
	T _____ R _____	_____
2 Property Controlling in Section	S _____ T _____ R _____	_____
	S _____ T _____ R _____	_____
3 Miscellaneous Property in Sec.	S _____ T _____ R _____	_____
	S _____ T _____ R _____	_____
4 Lot No _____, Recorded Plat _____		
5 Private Claims _____		

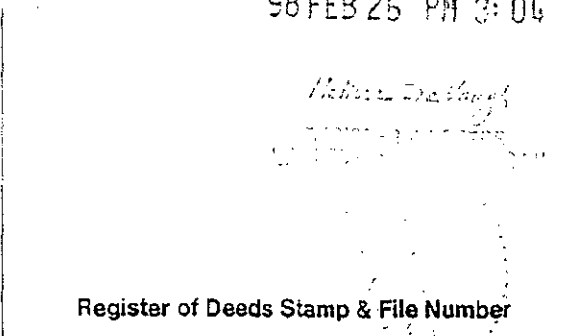

MICHAEL G. HAY in a field survey on AUGUST, 1997, do hereby certify that under requirements of P.A. 74, Michigan P.A. of 1970, the corner points mentioned in lines 1 and 2 above were in conformance with regulations and rules therefore as required in the current manual of survey instructions of the United States Department of the Interior, Bureau of Land Management or by a decree of a Court of Law and/or that the corner points mentioned in lines 3, 4 and 5 above were in conformance with the rules of the Michigan Board of Land Surveyors or by a Decree of a Court of Law; established, re-established, monumented, re-monumented, recovered, found as expressed below.

NOTE: Not more than 4 corners, all in the same town and range, may be recorded on this certificate.

	A	B	C	D	E	F	G	H	I	J	K	L	M
2	6	5	4	3	2	1							
3													
4	7	8	9	10	11	12							
5													
6	18	17	16	15	14	13							
7													
8	19	20	21	22	23	24							
9													
10	30	29	28	27	26	25							
11													
12	31	32	33	34	35	36							
13													

A. Description of original monument and accessories and/or subsequent restoration:

- JOSEPH WAMPLER P.S.
- 1975 Harold N. Elrich P.S. 18986 L 3 P 430 survey fnd iron N 20E 58.45' 18" Maple N 85W 23.77' 16" Elm S 45E 53.55' P. Pole
- 1975 Harold N. Elrich P.S. 18986 L 3 P 240 Land Corner Recordation certificate (same wits as 1975 survey above)
- 1976 Bernard Henderson P.S. 16043 L 3 P 958 survey fnd iron NE 58.45' 18" tree SE 53.55' Power Pole NW 23.77' 12" tree
- 1980 Harold N. Elrich P.S. 18986 L 5 P 710 survey fnd iron (same wits as 1976 survey above)
- 1981 Bernard Henderson P.S. 16043 L 6 P 331 survey fnd iron (same wits as 1975 survey above)
- 1985 Bernard Henderson P.S. 16043 L 6 P 963 survey fnd 1/2" iron (same wits as 1976 survey above)
- 1988 Earl E. Gravlin P.S. 23510 L 7 P 904 survey fnd iron (same wits as 1976 survey above)
- 1988 Earl E. Gravlin P.S. 23510 L 8 P 133 survey fnd iron (same wits as 1976 survey above)
- 1993 Earl E. Gravlin P.S. 23510 L 10 P 432 survey fnd iron (same wits as 1976 survey above)
- 1996 Harold N. Elrich P.S. 18986 not recorded fnd 1/2" iron N 45W 30.70' 14" Elm S 45W 32.56' 20" Maple N 35E 58.77' 12" Maple

B. Description of corner evidence found and/or method applied in restoring or reestablishing corner:

- 1997 ROWE Engineering; Hay, P.S. 41101; fnd 1/2" iron at centerline Davis Rd & Five Lakes Road. Recovered 2 previous witnesses indicating that found iron is the same position as 1975 iron cited above.
- A-2 to A-1 3000.48'
- A-2 to B-2 2430.78'
- A-2 to A-3 2652.60'
- A-2 to M-2 (Lapeer) 125.18' NORTH

Michael G. Hay
10-13-97

C. Description of monument for corner and accessories established to perpetuate locating the position of the corner:

- A-2 Placed Remonumentation Cap on found 1/2" iron rod
- N 35E 58.77' Spike 12" Maple
- S 45W 32.56' Spike 20" Maple
- N 85W 23.55' Spike 12" Elm
- N 45W 30.70' Spike 14" Elm



Signed by Michael G. Hay Date September 26, 1997
Surveyor's Michigan License No. 41101