

SURVEY & REMONUMENTATION

MAR 13 1998

SECTION

**REMONUMENTATION
LAND CORNER RECORDATION CERTIFICATE
Filing Requirement of Act 74, Mich. P.A. 1970**

RECEIVED FOR RECORD

98 FEB 26 PM 3:06

For corners in

LAPEER	Located In:	Corner Code #
Public Land Survey	T <u>7N</u> R <u>11E</u>	<u>A-4</u>
	T _____ R _____	_____
	T _____ R _____	_____
	T _____ R _____	_____
Property Controlling in Section	S _____ T _____ R _____	_____
	S _____ T _____ R _____	_____
Miscellaneous Property in Sec.	S _____ T _____ R _____	_____
	S _____ T _____ R _____	_____

Register of Deeds Stamp & File Number

4 Lot No. _____, Recorded Plat _____
5 Private Claims _____

	A	B	C	D	E	F	G	H	I	J	K	L	M
2	6	5	4	3	2	1							
3													
4	7	8	9	10	11	12							
5													
6	18	17	16	15	14	13							
7													
8	19	20	21	22	23	24							
9													
10	30	29	28	27	26	25							
11													
12	31	32	33	34	35	36							
13													

MICHAEL G. HAY in a field survey on AUGUST, 19 97, do hereby certify that under requirements of P.A. 74, Michigan P.A. of 1970, the corner points mentioned in lines 1 and 2 above were in conformance with regulations and rules therefore as required in the current manual of survey instructions of the United States Department of the Interior, Bureau of Land Management or by a decree of a Court of Law and/or that the corner points mentioned in lines 3, 4 and 5 above were in conformance with the rules of the Michigan Board of Land Surveyors or by a Decree of a Court of Law, established, re-established, monumented, re-monumented, recovered, found as expressed below

NOTE: Not more than 4 corners, all in the same town and range, may be recorded on this certificate.

- A Description of original monument and accessories and/or subsequent restoration:
- 1822 GLO; Joseph Wampler D.S.
 - 1874 GILBERT BATES L.S. stone 20:11.9 small stones earthen 1.65 south of Lapeer corner.
 - 1979 Earl E. Gravlin P.S. 23510 L005 P341 survey ; S 45 E 43.75 20" stump N 50 E 40.20' 20" dead elm East 36.33' nail 6' cherry N 25 W 80.59 RR sign
 - 1988 Earl E. Gravlin P.S. 23510 L004 P166 land corner recordation certificate fnd iron (same wits as 1979 survey above)


- B. Description of corner evidence found and/or method applied in restoring or reestablishing corner:
- 1997 ROWE ENG; Michael G. Hay P.S. 41101 fnd 1/2" iron in centerline of Five Lakes Road. No occupation East or West. Measured distance to A-3 indicates that fnd iron is in the same position as 1979 corner site above.

A-4 to A-3 2633.73'
A-4 to A-5 2673.84'
A-4 to B-4 2485.60'
A-4 to M-4 (Lapeer) 88.69' County notes (1.65) 108.90' NORTH

Michael G. Hay
10-13-97

- C Description of monument for corner and accessories established to perpetuate locating the position of the corner:

A-4 set standard remon cap on fnd 1/2" iron
S 85 E 30.07' pk nail & remon washer
S 35 W 43.34' spike 8" pine
S 80 W 37.29' spike 8" pine
N 80 W 40.33' spike 10" pine

 

Signed by Michael G. Hay Date September 26, 1997

Surveyor's Michigan License No. 41101