

**SURVEY &
REMONUMENTATION**

MAR 13 1998

SECTION


**REMONUMENTATION
LAND CORNER RECORDATION CERTIFICATE
Filing Requirement of Act 74, Mich. P.A. 1970**

RECEIVED RECORD
98 FEB 25 PM 3:09

For corners in
Lapeer

Located In: Corner Code A-6

1. Public Land Survey	T <u>7N</u> R <u>11E</u>	<u>A-6</u>
	T _____ R _____	_____
	T _____ R _____	_____
	T _____ R _____	_____
2. Property Controlling in Section	S _____ T _____ R _____	_____
	S _____ T _____ R _____	_____
3. Miscellaneous Property in Sec.	S _____ T _____ R _____	_____
	S _____ T _____ R _____	_____

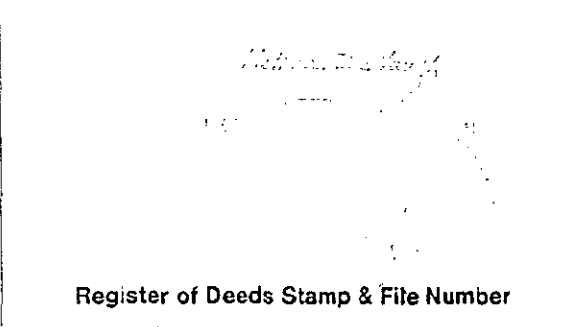

4. Lot No. _____, Recorded Plat _____
5. Private Claims _____

	A	B	C	D	E	F	G	H	I	J	K	L	M
2	6	5	4	3	2	1							
3													
4	7	8	9	10	11	12							
5													
6	18	17	16	15	14	13							
7													
8	19	20	21	22	23	24							
9													
10	30	29	28	27	26	25							
11													
12	31	32	33	34	35	36							
13													

I, MICHAEL G. HAY in a field survey on AUGUST, 19 97, do hereby certify that under requirements of P.A. 74, Michigan P.A. of 1970, the corner points mentioned in lines 1 and 2 above were in conformance with regulations and rules therefore as required in the current manual of survey instructions of the United States Department of the Interior, Bureau of Land Management or by a decree of a Court of Law and/or that the corner points mentioned in lines 3, 4 and 5 above were in conformance with the rules of the Michigan Board of Land Surveyors or by a Decree of a Court of Law; established, re-established, monumented, re-monumented, recovered, found as expressed below:

NOTE: Not more than 4 corners, all in the same town and range, may be recorded on this certificate.

A. Description of original monument and accessories and/or subsequent restoration:

Joseph Wampler D.S.
1874 Gilbert Bates set stakes pine 18 S 66½' W 32 pine 23 S 60 E 41
1972 Robert G Kay P.S. 14096 L002 P025 surveys N 40 W 65.45' Nail T.P. S 70 E 88.48 Nail T.P. S 50 E 21.70' North west corner bridge abutment

B. Description of corner evidence found and/or method applied in restoring or reestablishing corner:

1997 ROWE ENG; Michael G. Hay P.S. 41101 fnd ½" iron at centerline of Five Lakes Road north-south and tree line running to the East.

A-6 to A-5 2633.27'
A-6 to A-7 2621.75'
A-6 to B-6 2518.45' (Kay)
A-6 to M-6 (Lapeer) 89.55' NORTH

Michael G. Hay
10-13-97

C. Description of monument for corner and accessories established to perpetuate locating the position of the corner:

A-6 Set standard remon cap on fnd ½" iron
N 35 W 85.71' spike 12" elm
S 25 W 95.52 spike 12" cherry
East 64.49' spike power pole
S 85 W 33.82' spike 10" hickory

Signed by Michael G. Hay Date September 26, 1997
Surveyor's Michigan License No. 41101